


T.5S.R.3W.W.M.

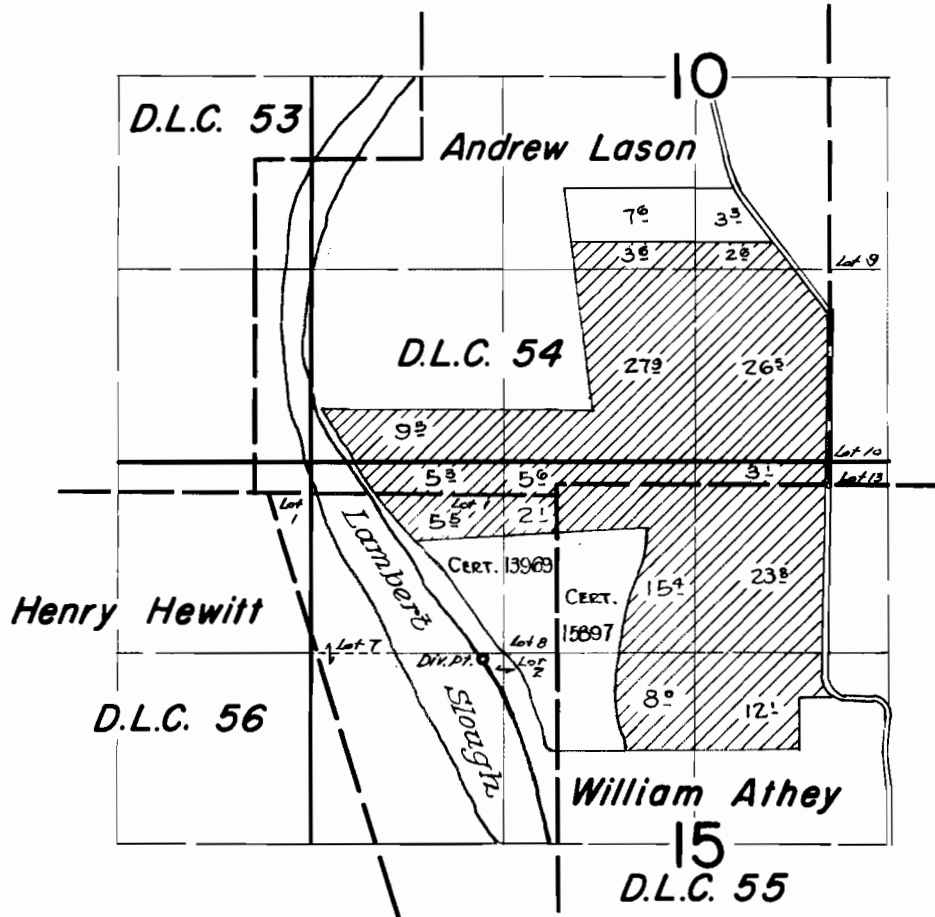

FINAL PROOF SURVEY
UNDER

Application No. **34994** Permit No. **27434**
IN NAME OF

ESTATE OF U. S. ALDERMAN

Surveyed Sept. 25 1964, by *R. Johnson*