


# T.4S.R.3W.W.M.

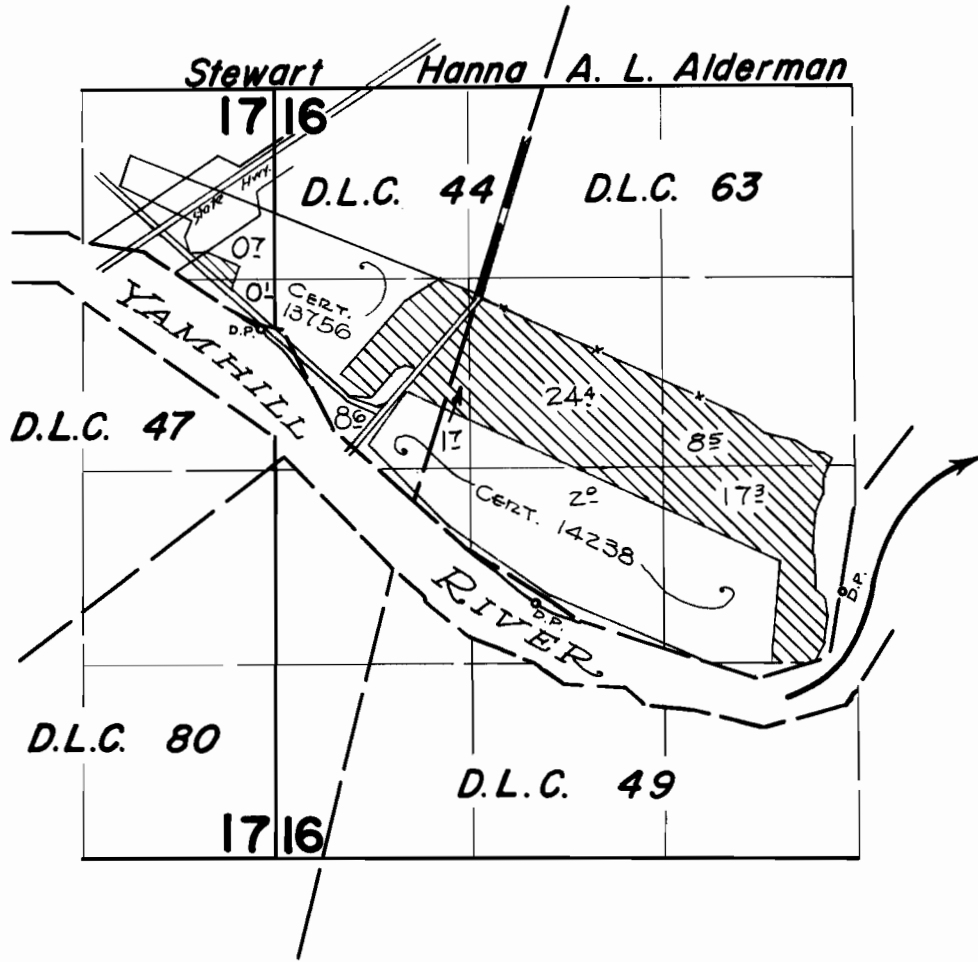

## FINAL PROOF SURVEY UNDER

Application No. **37182** ... Permit No. **27686**  
IN NAME OF

**U. S. ALDERMAN**

Surveyed July 3, 1963, by

*A. L. Alderman*