


T.5S.R.5W.W.M.

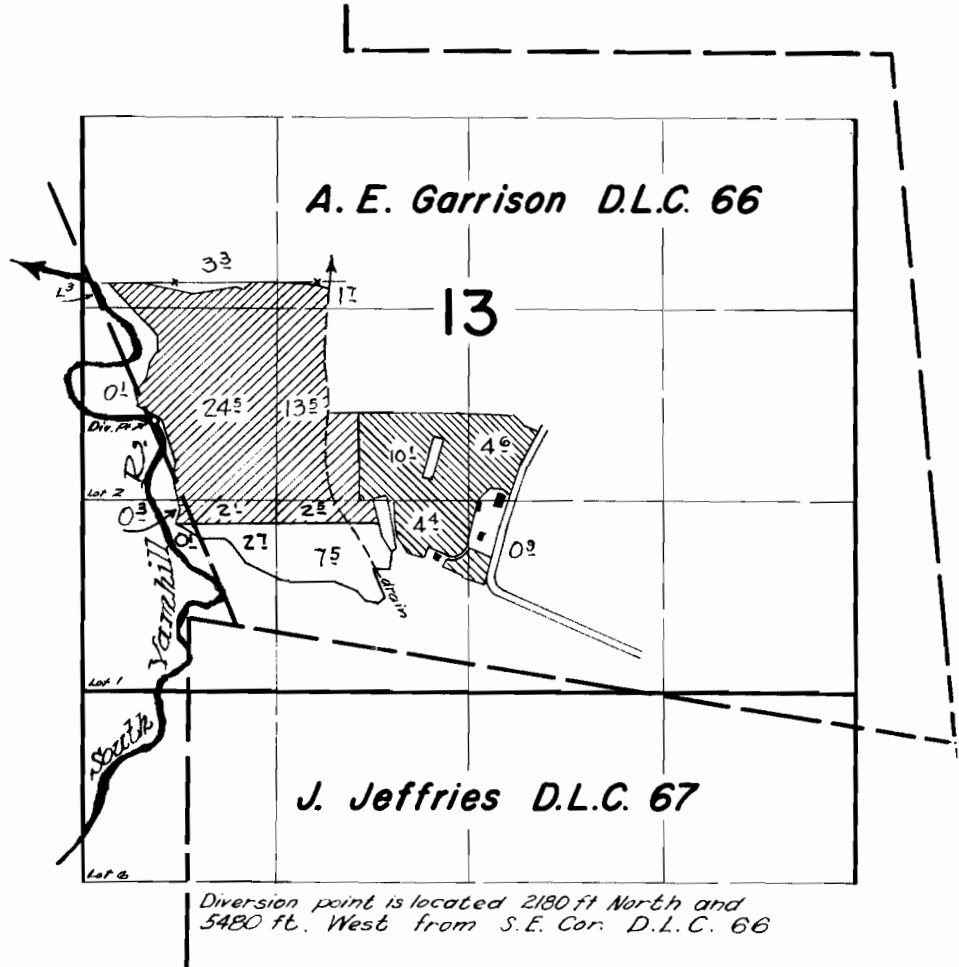

**FINAL PROOF SURVEY**  
UNDER

Application No. **37316** Permit No. **27798**  
IN NAME OF

**RUSSELL SHELDON**

Surveyed August 7, 1964, by *R. Jackson*