


T.4S.R.3W.W.M.

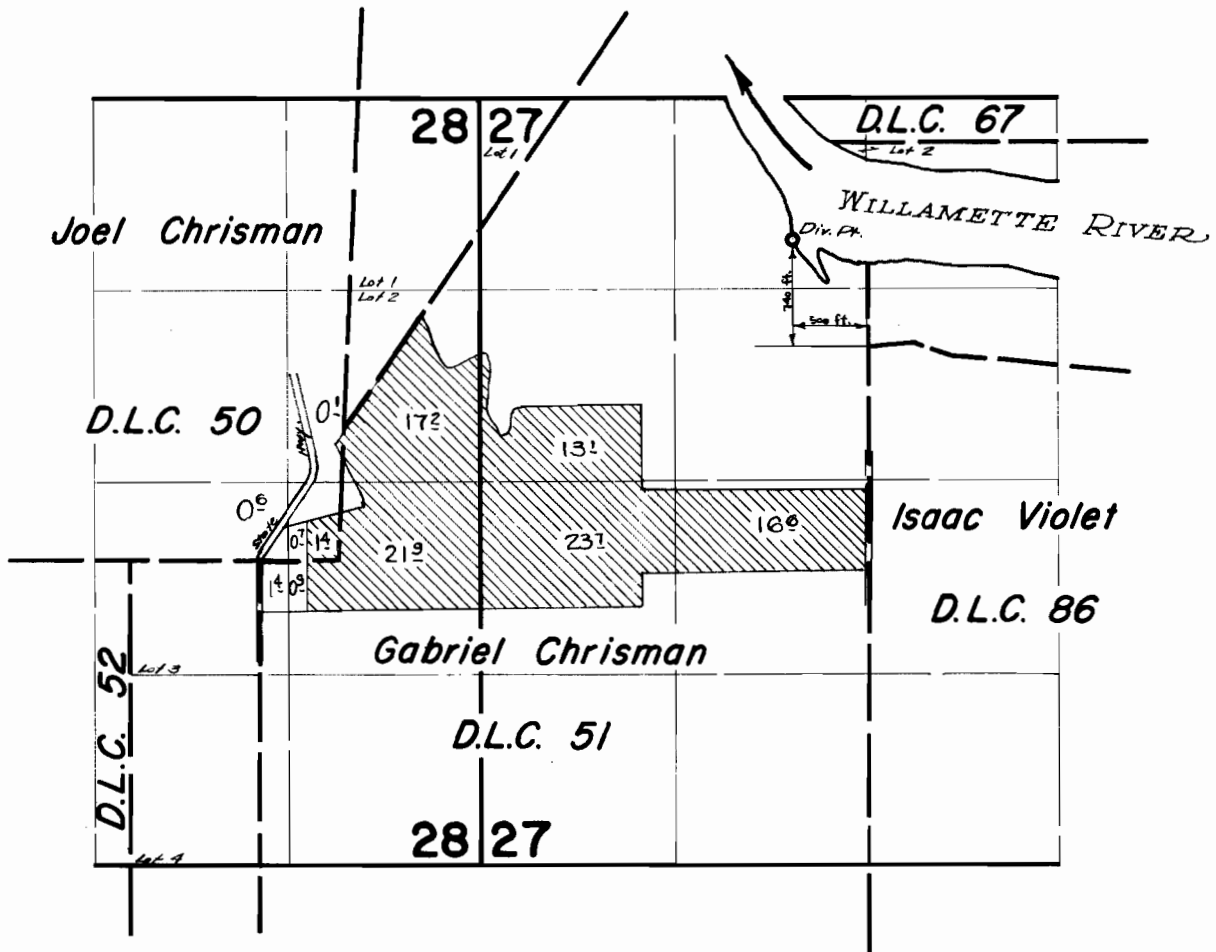

**FINAL PROOF SURVEY**  
UNDER

Application No. 38454. Permit No. 28639.  
IN NAME OF

HUBERT L. WILSON

Surveyed August 24 1904, by *A. H. Jackson*