


T.3S. R.3 W. W.M.

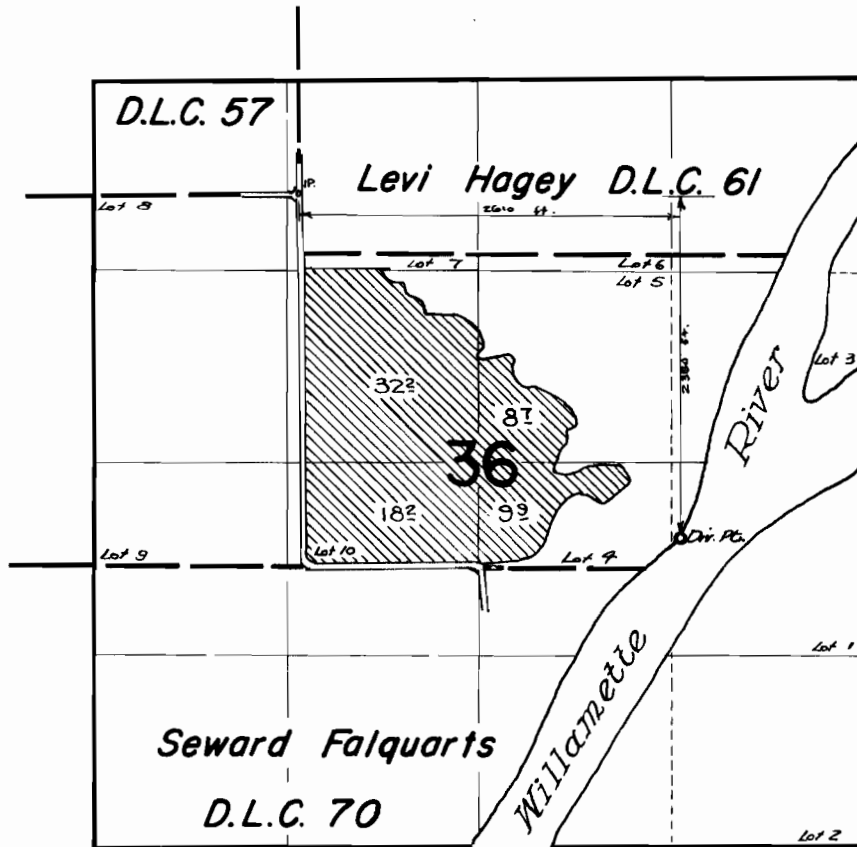

FINAL PROOF SURVEY
UNDER

Application No. **38705** Permit No. **28821**
IN NAME OF

FRANK HARDING

Surveyed *Sept 22 1964*, by *R. Jackson*