


T. 5S. R. 10W. W.M.

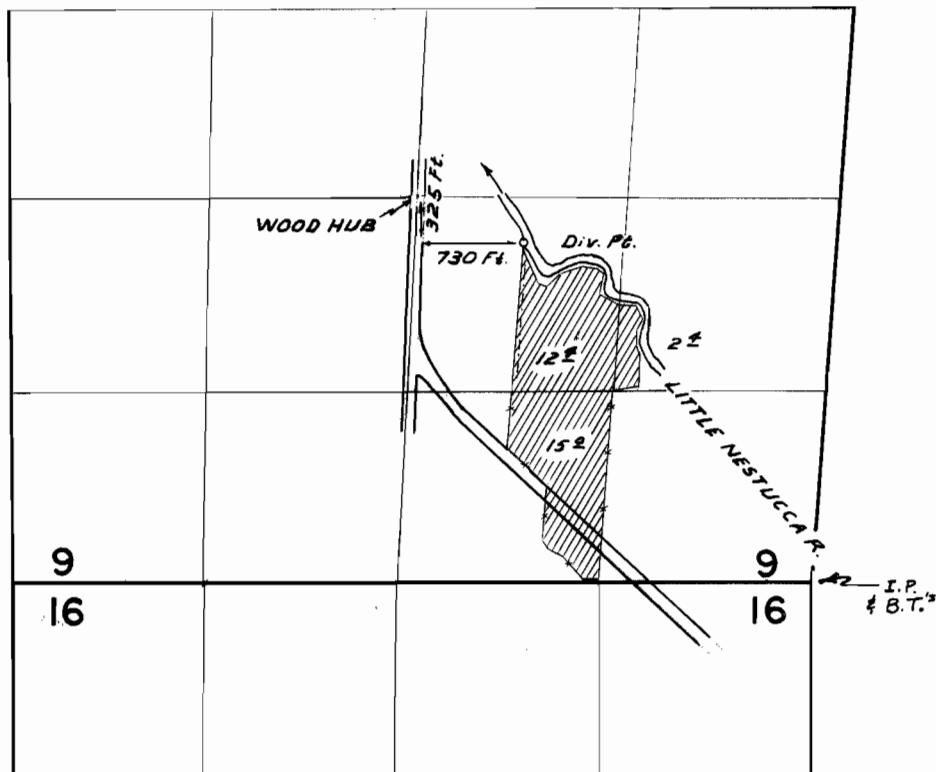

FINAL PROOF SURVEY
UNDER

Application No. 29182 Permit No. 22993
IN NAME OF

CLEM HURLIMAN

Surveyed SEPT. 23 1955, by M. BISH