


T. 4 N. R. 2 W. W.M.

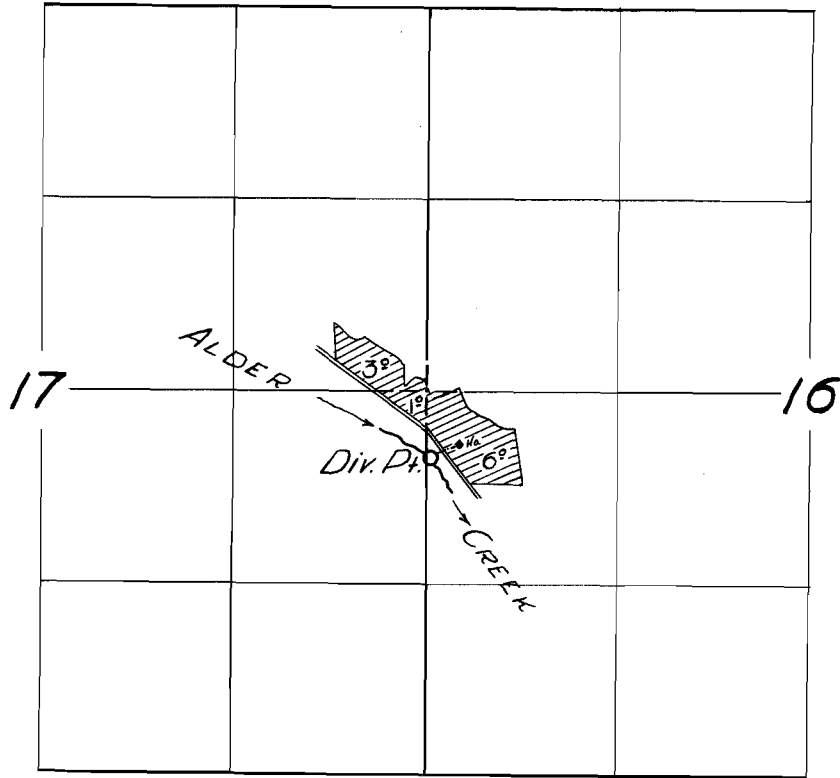

FINAL PROOF SURVEY
UNDER

Application No. 27750 Permit No. 21852

IN NAME OF

JAMES R. GILL

Surveyed 13 July 1956, by R. Whitley