


T. 1 S. R. 4 W. W. M.

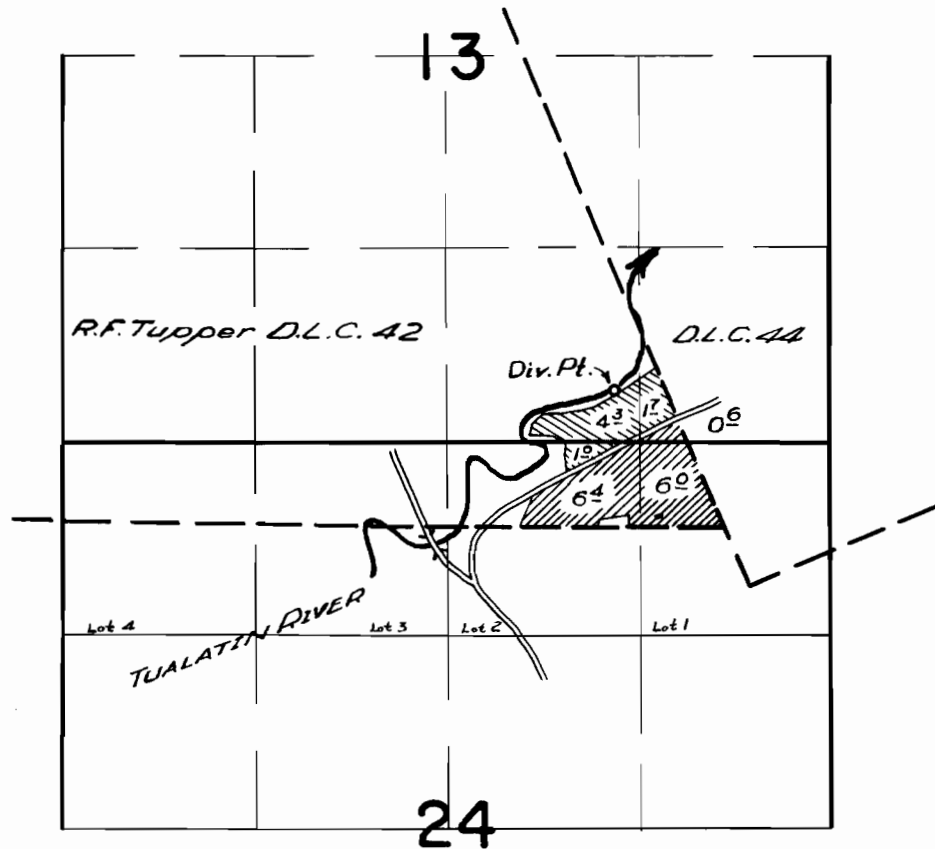

FINAL PROOF SURVEY
UNDER

Application No. 22237 25620 Permit No. 17503 20098
IN NAME OF

MRS. VIRGINIA BRIDGES

Surveyed April 15, 1952, by H.L. Coffman