

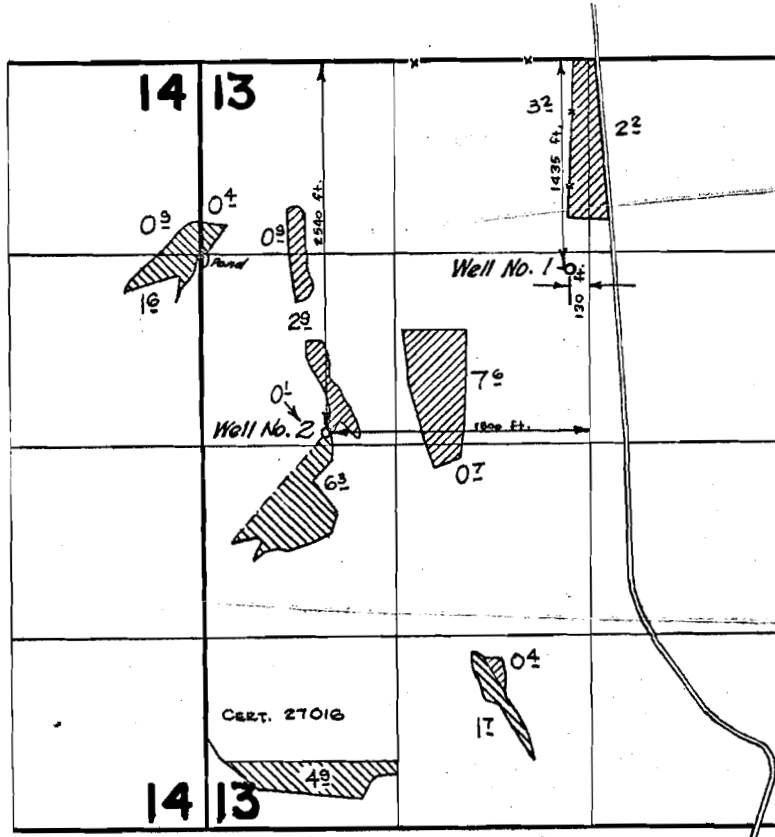
6-12-96



33060

33258

T.40S.R.11E.W.M.

Lost Priv. Wells



Well No. 1 
 Well No. 2 

FINAL PROOF SURVEY UNDER

Application No. G-1404... Permit No. G-1296...
IN NAME OF

LADDIE & CARL RAJNUS

Surveyed June 9, 1964, by *R. Jackson*