


T. 10 S. R. 2 W. W. M.

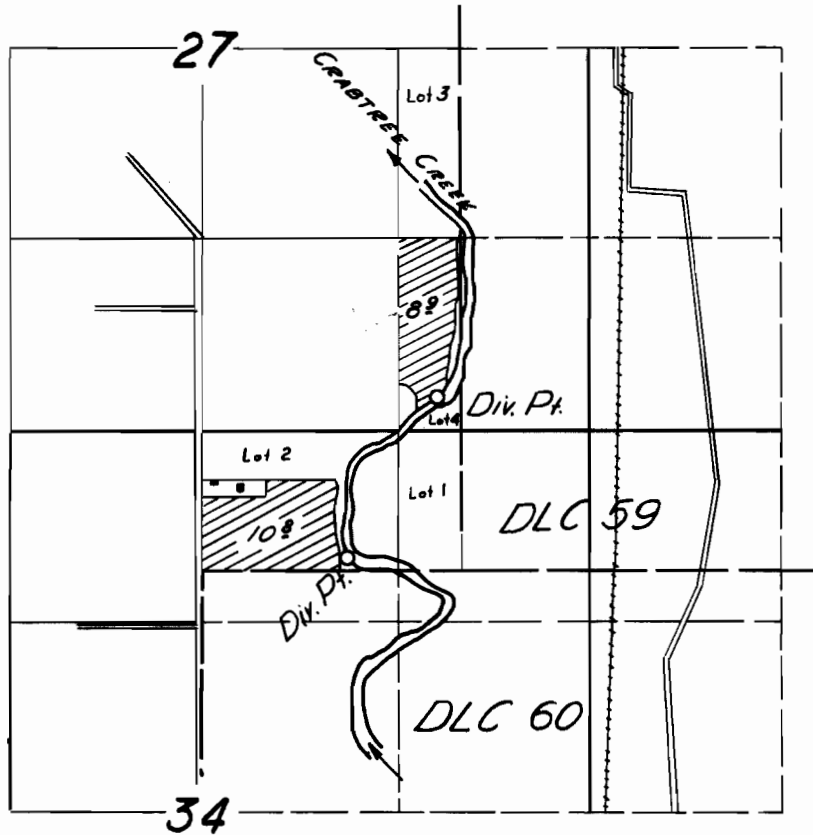

FINAL PROOF SURVEY
UNDER

Application No. 24617 Permit No. 19651

IN NAME OF

GARY VANDERSTRASSE

Surveyed 27 July, 1956, by *C. Whitby*