


T.4S. R.3W.W.M.

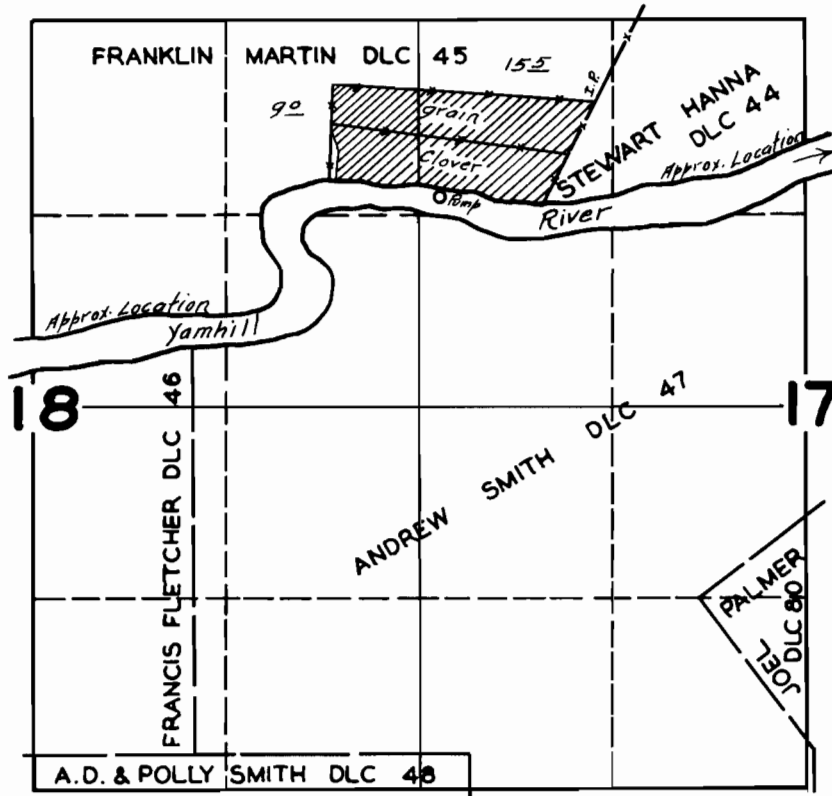

FINAL PROOF SURVEY

UNDER

Application No. 19268 Permit No. 14865

IN NAME OF

JOEL W. STEWART

Surveyed JULY 13, 1944, by

John R. Sumrell