


T.5N. R.7W.W.M.

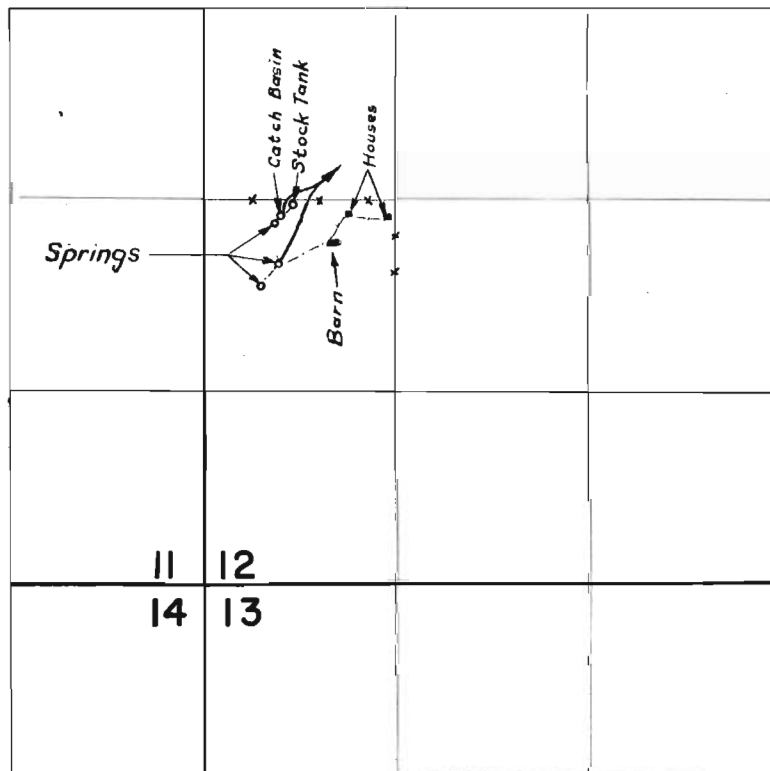

FINAL PROOF SURVEY
UNDER

Application No. 21403 Permit No. 16782
IN NAME OF

BENOIT YOSS

Surveyed May 18, 1964, by M. Bish

1964-1A

S.L.