


T.6S., R.44E.W.M.

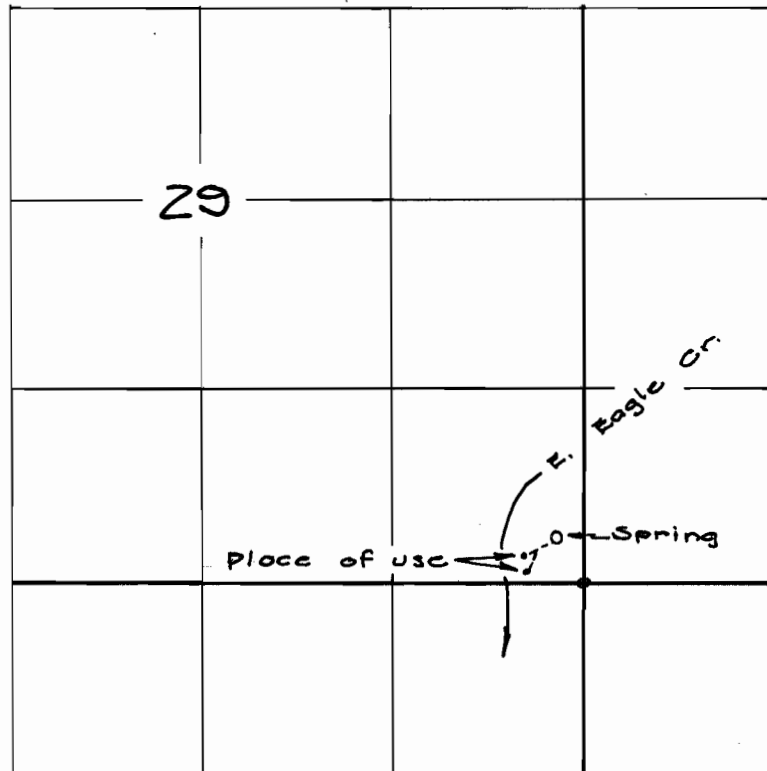

FINAL PROOF SURVEY
UNDER

Application No. 39316 Permit No. 29279
IN NAME OF

JAMES F. ALLEN & ROY CHADWELL

Surveyed Oct. 20 1964 by D. B. Hall