


# T.4N. R.9W. W.M.

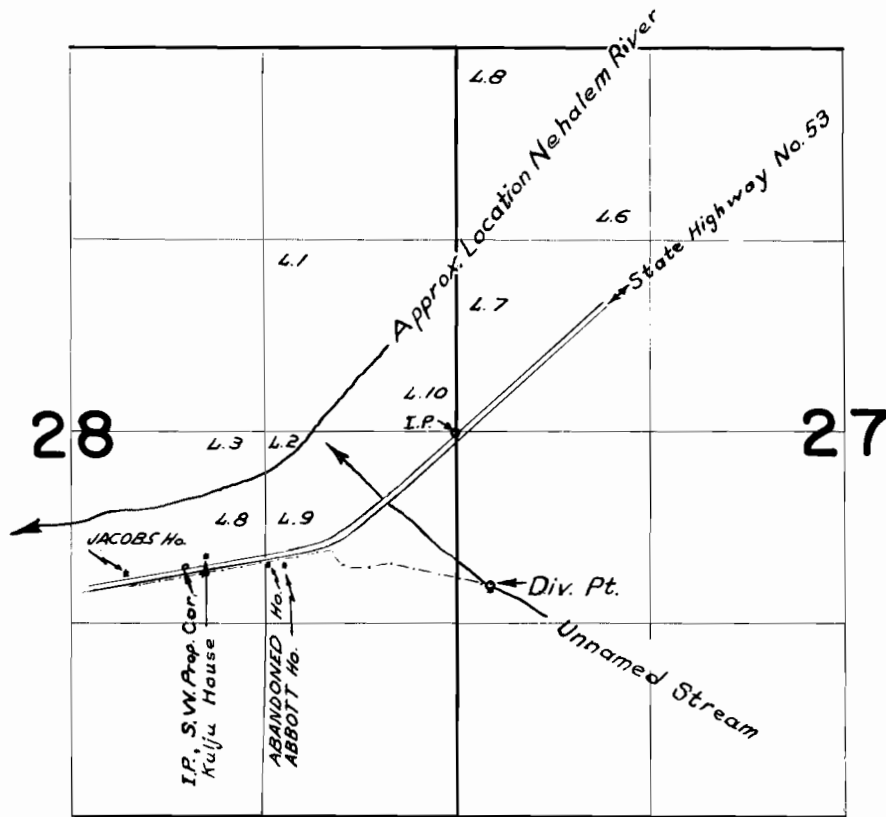

*Note: Kulju House served by this Permit*

## FINAL PROOF SURVEY UNDER

Application No. 37765. Permit No. 28139  
IN NAME OF

D.T. WATERHOUSE & G. S. GRAY

Surveyed May 19 1964, by M. Bish