


T. 4N. R. 3W. W.M.

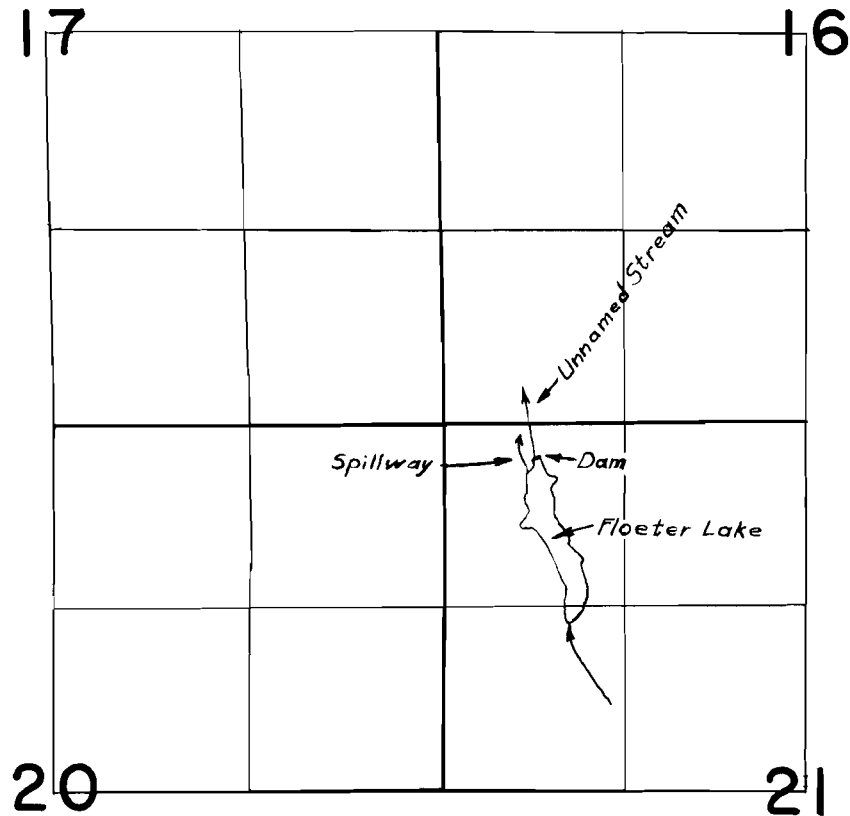

**FINAL PROOF SURVEY**  
UNDER

R-37702

R-3134

Application No. 38023. Permit No. 28338.  
IN NAME OF

OREGON STATE GAME COMMISSION

Surveyed Oct. 6, 1964, by M. Bish