


T. 8N. R. 4W. W.M.

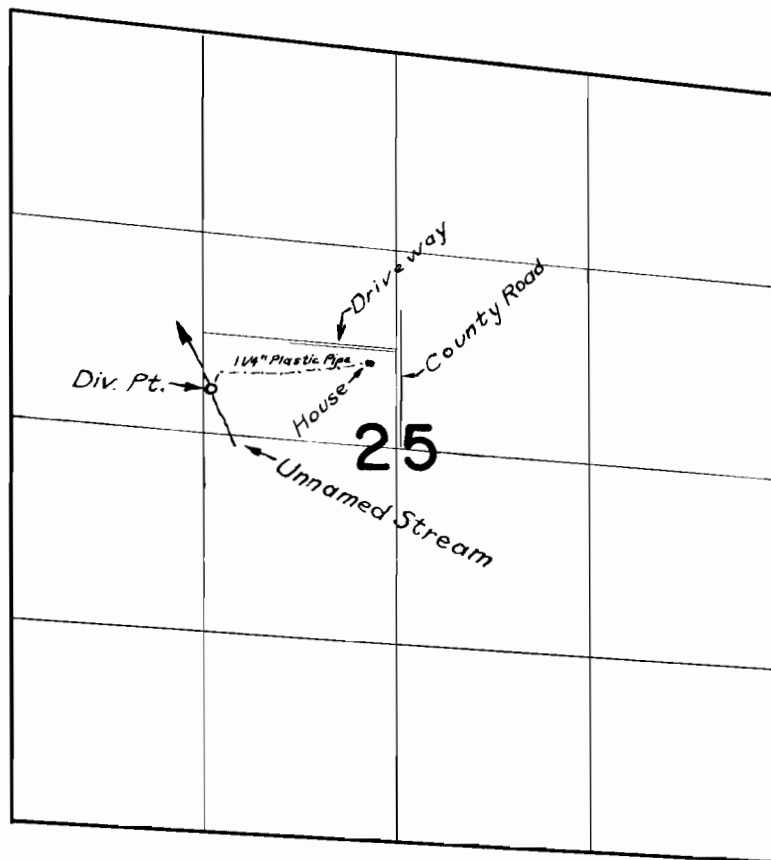

FINAL PROOF SURVEY
UNDER

Application No. 38341 Permit No. 28539
IN NAME OF

RUFUS J. HICKS

Surveyed Oct. 9 1964, by M. Bish