


T. 32 S. R. 3 W. W.M.

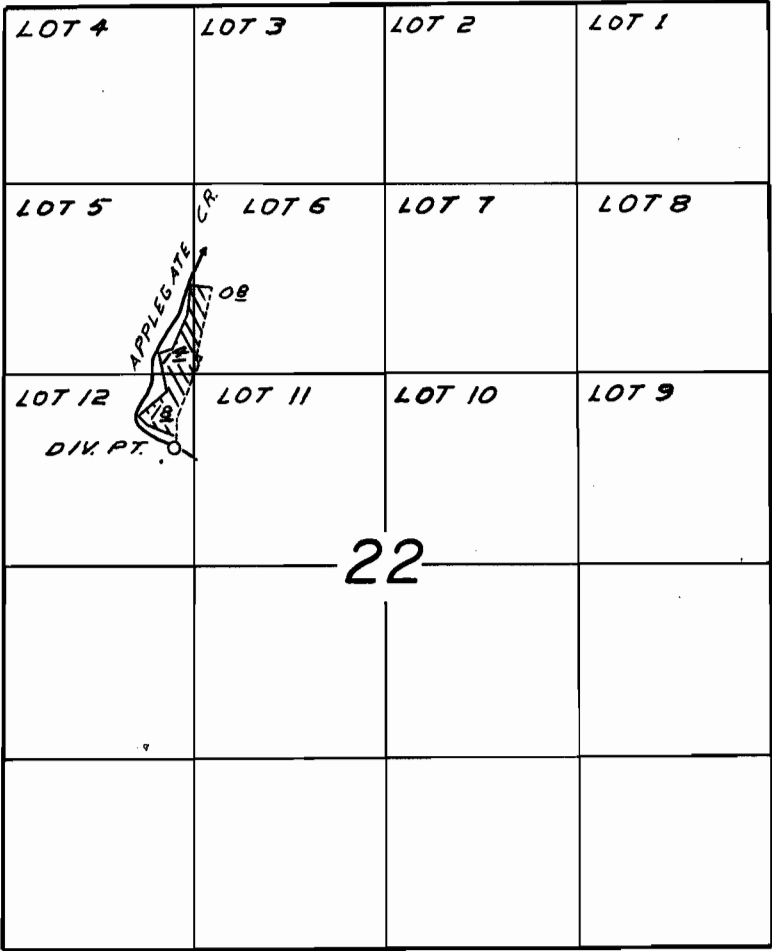

FINAL PROOF SURVEY
UNDER

Application No. 37793 Permit No. 28194
IN NAME OF

S. E. NEIDERHEISER

Surveyed SEPT. 3 1965, by B. RUPPERT