


# T.36 S.R.4 W.W.M.

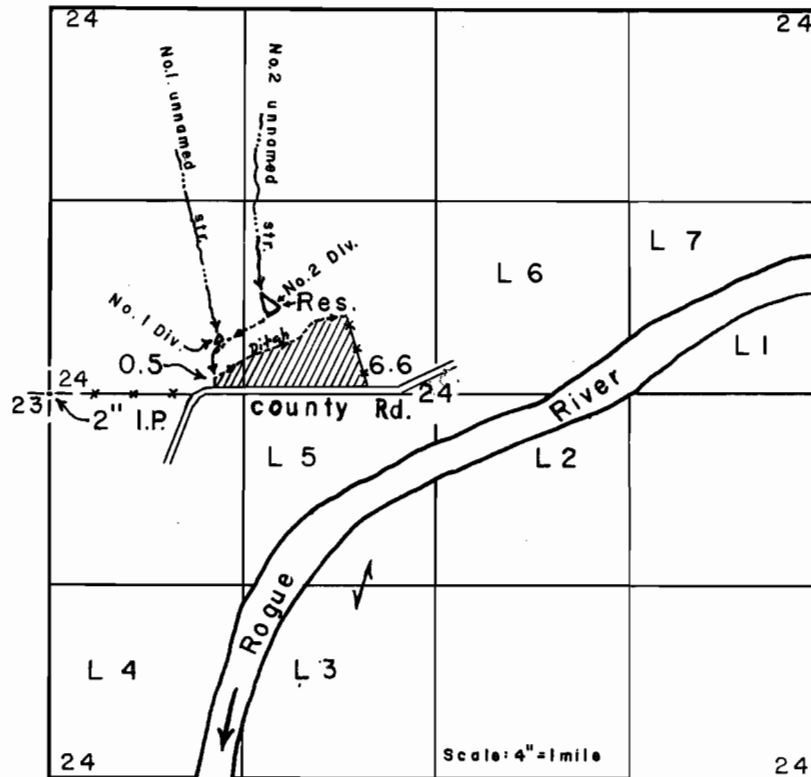

## FINAL PROOF SURVEY UNDER

R-31775 R-2057  
Application No. 31776 Permit No. 25048  
IN NAME OF

Geo. W. McCollum

Surveyed July 17, 1963, by C. Baker & D.C.H.