


T. 40 S. R. 8 W. W. M.

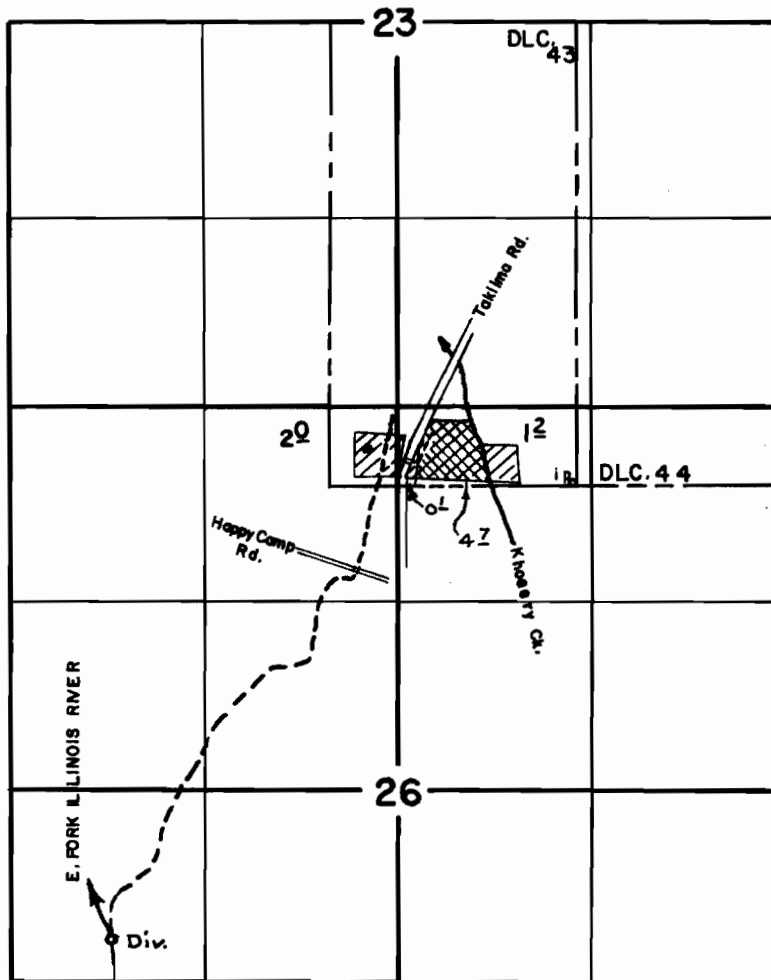

FINAL PROOF SURVEY

UNDER

PRIMARY 

SUPPLEMENTAL 

Application No. 33887 Permit No. 26705

IN NAME OF

SPIERS L. & MARY WILSON

May 20 1966

Surveyed May 10 1965, by R. B. Steimer