


Basin 14


26669, 33271

29023 33277

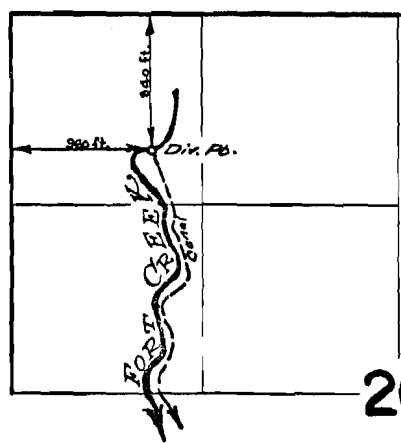

T.33 & 34 S. R. 7 1/2 E. W.M.

26

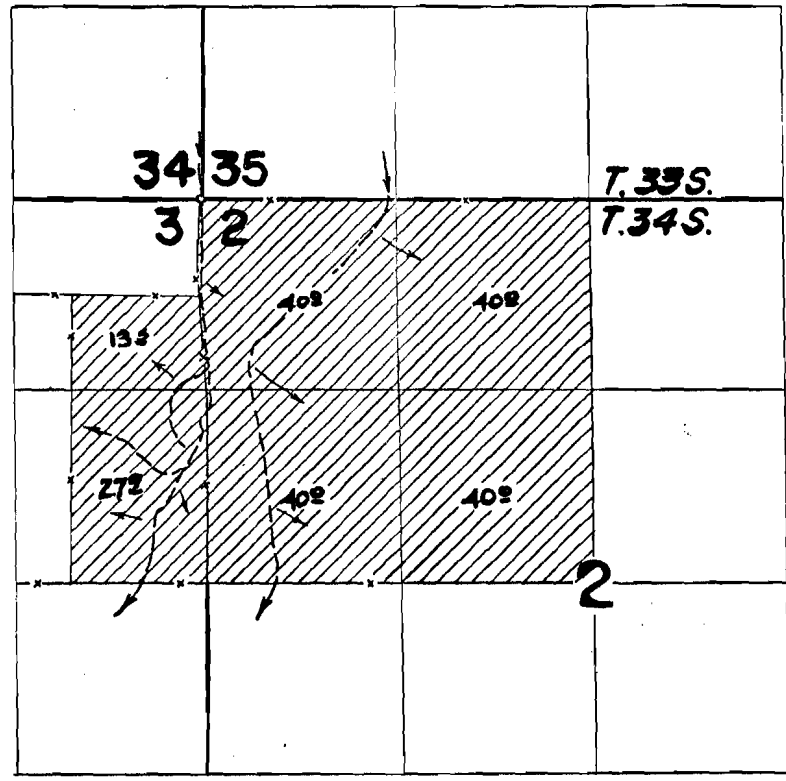

wood Co. misc.

FINAL PROOF SURVEY UNDER

33780 Application No. 38878... Permit No. 29023... IN NAME OF

26669 Filed under Crooked & Misc.

LLOYD G. & DOROTHY M. NICHOLSON

Surveyed August 19 1964., by [Signature]