



Basin 14

26669.3327

29023 33277

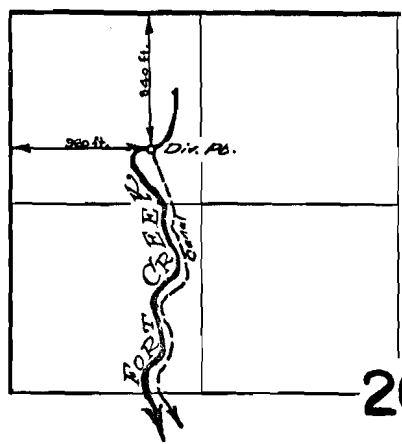

T.33 & 34 S. R. 7 1/2 E. W.M.

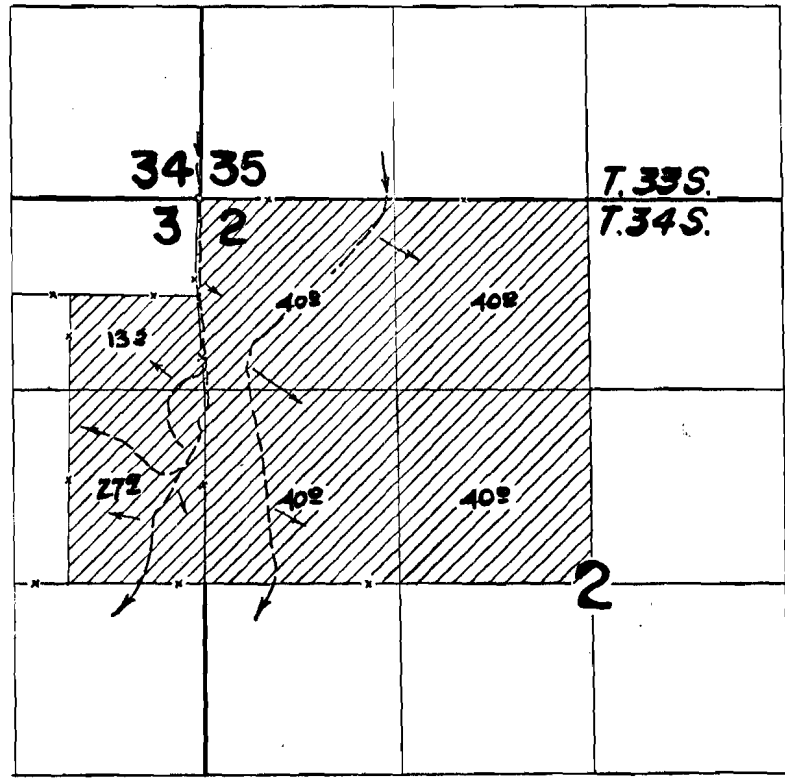

wood Tr. misc.

FINAL PROOF SURVEY
UNDER

33780
Application No. 38878... Permit No. 29023...
IN NAME OF

26669 - Filed under Crooked & Misc.

LLOYD G. & DOROTHY M. NICHOLSON

Surveyed August 19 1964., by *L. Peterson*