


T.33&34S.R.7½ E.W.M.

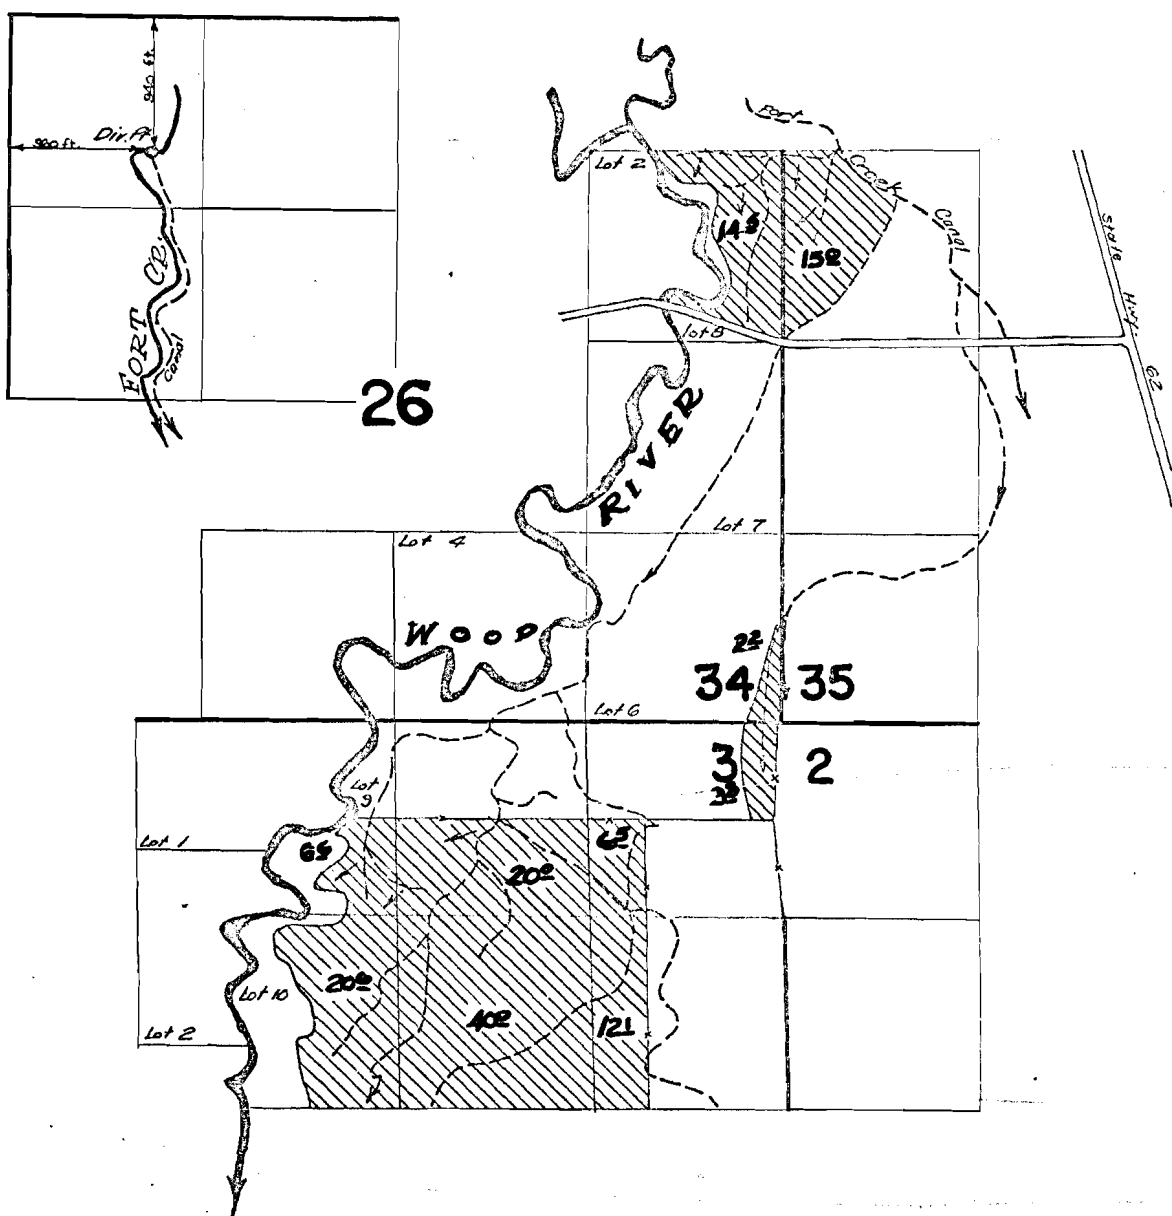

FINAL PROOF SURVEY UNDER

Application No. 39084... Permit No. 29099...
IN NAME OF

SUSAN J. MCAULIFFE

Surveyed August 18, 1964, by *A. Jackson*