


T. 12 S. R. 4 W. W. M.

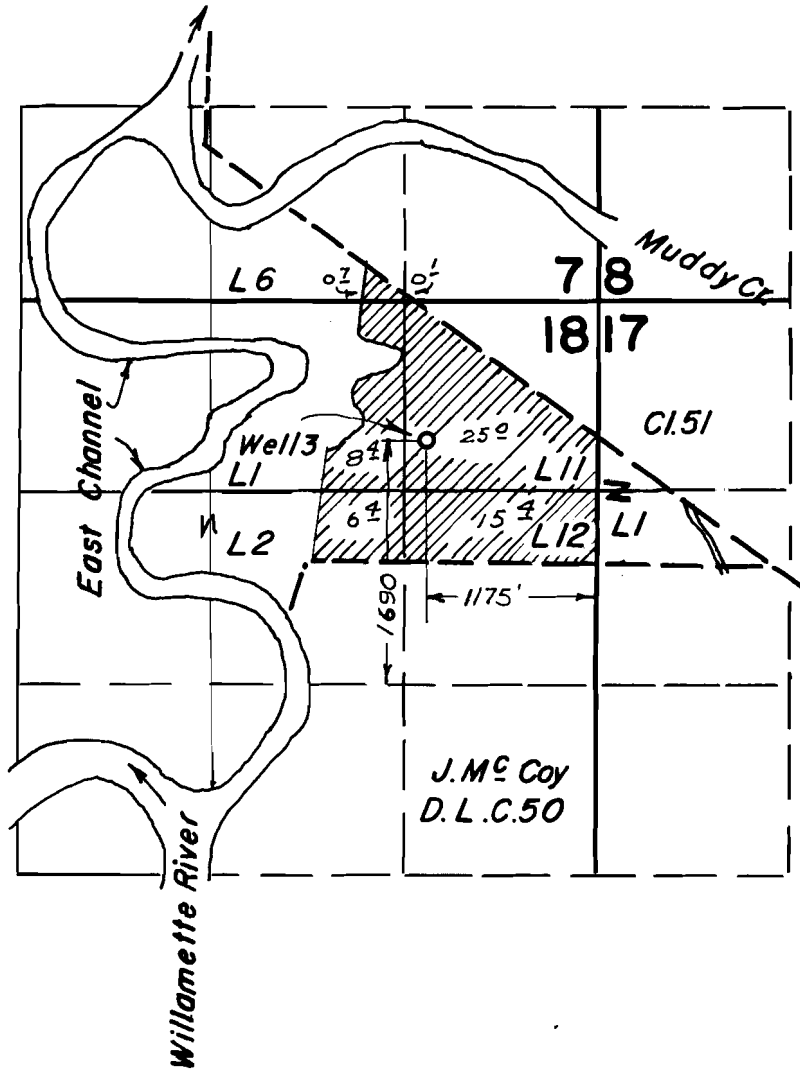

**FINAL PROOF SURVEY**  
UNDER

Application No. G-2021 Permit No. G-1860  
IN NAME OF

***F.M & Floy O. Lamb***

Surveyed July 1 1963, by C. Baker