


T. 12 S. R. 4 W. W. M.

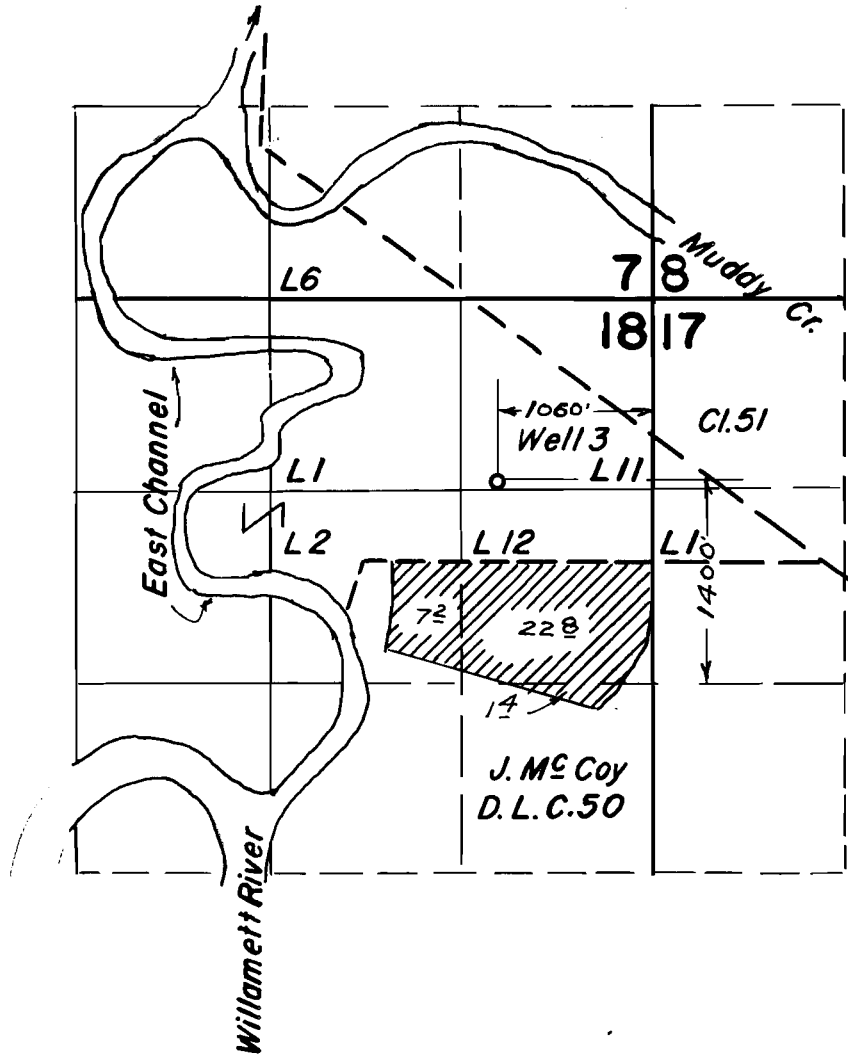

FINAL PROOF SURVEY
UNDER

Application No. G-2022 Permit No. G-1861
IN NAME OF

F.M. & Floy O. Lamb

Surveyed July 1 1963, by C. Baker