


T. 7 S. R. 2 W. W. M.

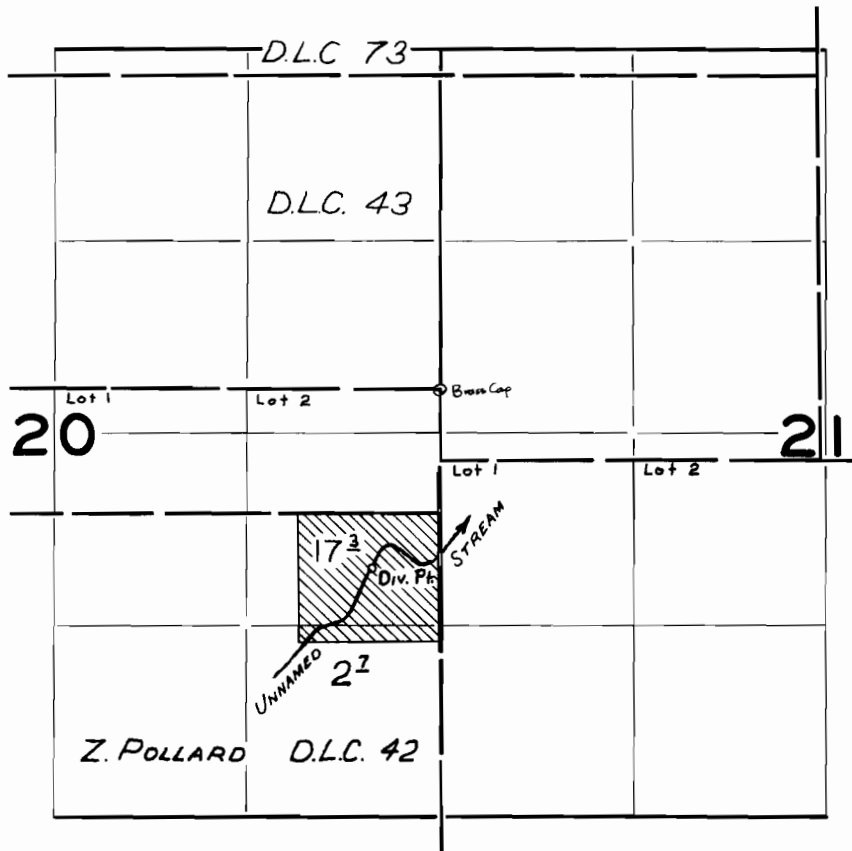

FINAL PROOF SURVEY
UNDER

Application No. 34472 Permit No. 27074

IN NAME OF

OTTO EMIL FOLK

Surveyed JUN. 22 1964, by R. JACKSON