


# T.9S.R.5W. W.M.

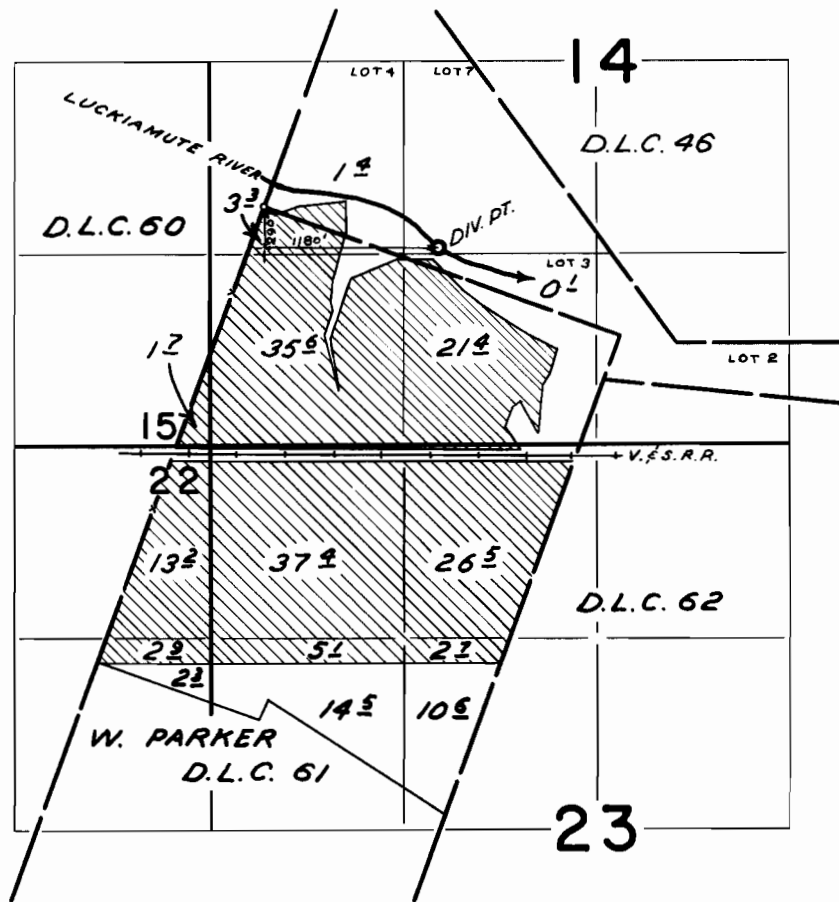

## FINAL PROOF SURVEY UNDER

Application No. 37335 Permit No. 27812  
IN NAME OF

**Stephen Benedict**

Surveyed Aug. 4 1965, by C. GARDNER