


T. IS. R. 10 W. W. M.

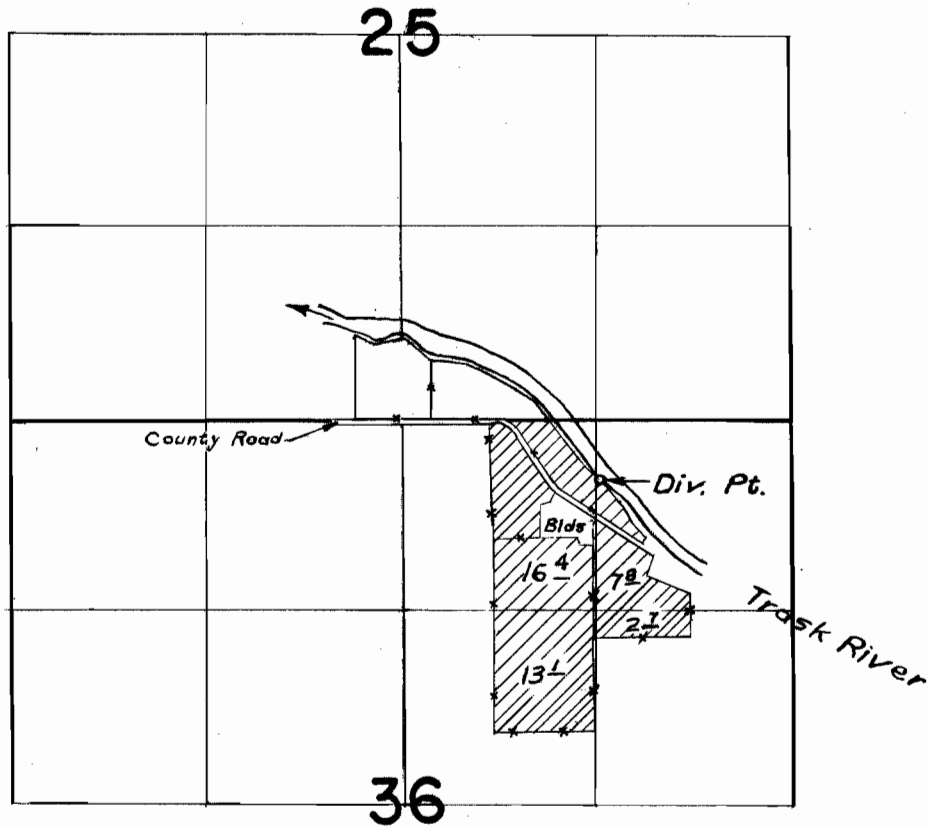

FINAL PROOF SURVEY
UNDER

Application No. 33860. Permit No. 26691...
IN NAME OF

..... EZRA GALLOWAY

Surveyed June 8, 1964, by M. Bish.....