


T.3N. R.9W.W.M.

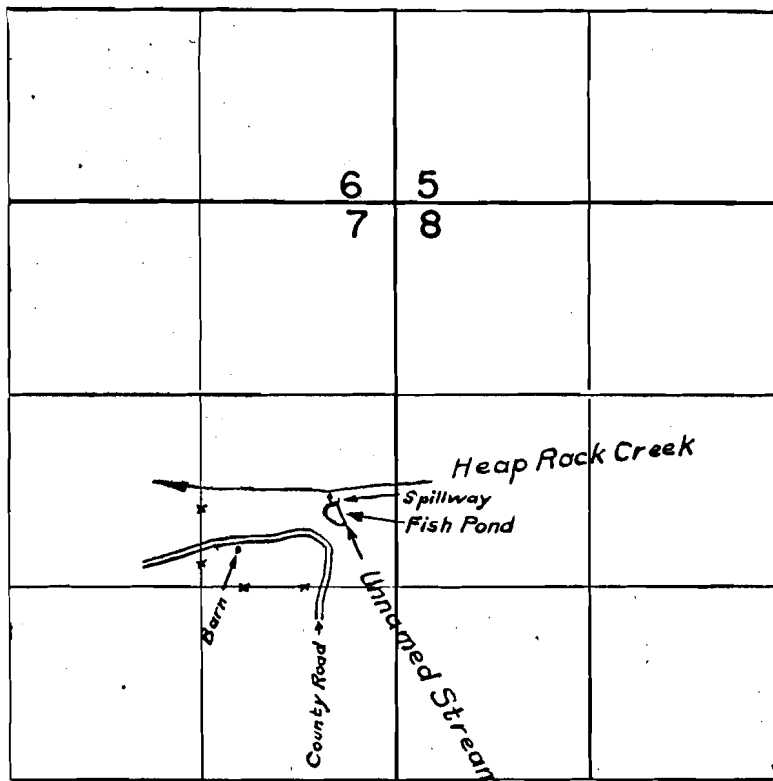

FINAL PROOF SURVEY
UNDER

R-33919 R-2340
Application No. 33920 Permit No. 26721..
IN NAME OF

.....RICHARD N. VON.....

Surveyed June 9, 1964, by M. Bish.....