


T.5S. R.10W. W.M.

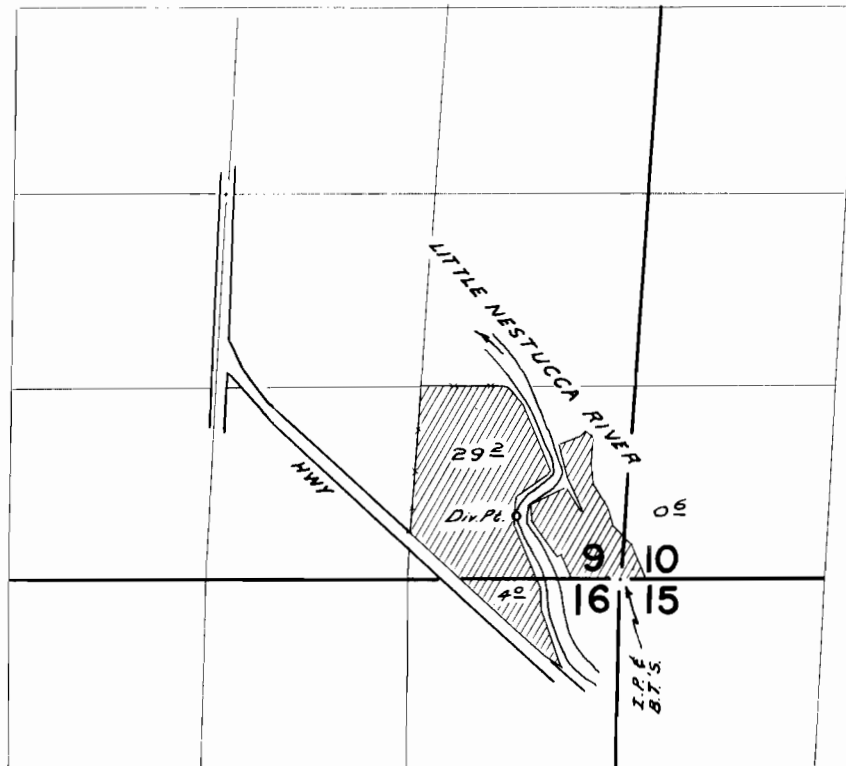

Div. Pt. LOCATED 450 Ft. N & 700 Ft. W. FROM SE Cor. Sec. 9

**FINAL PROOF SURVEY**  
UNDER

Application No. **34517** Permit No. **27138**  
IN NAME OF

**WALTER C. & KATHRYN E. BODYFELT**

Surveyed **JUNE 11** 19**64**, by **M. BISH**