


T. IN. R. IOW. W.M.

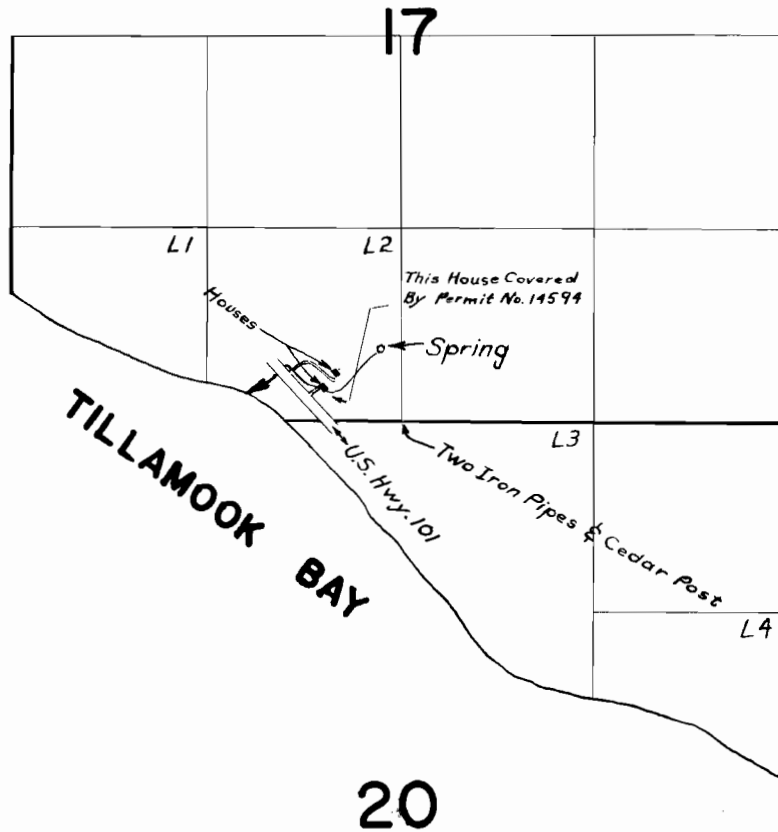

**FINAL PROOF SURVEY**  
UNDER

Application No. 38671 Permit No. 28777  
IN NAME OF

ADA. R. NELSON

Surveyed June 9 1964, by M. Bish