


T.3S.R.9W.W.M.

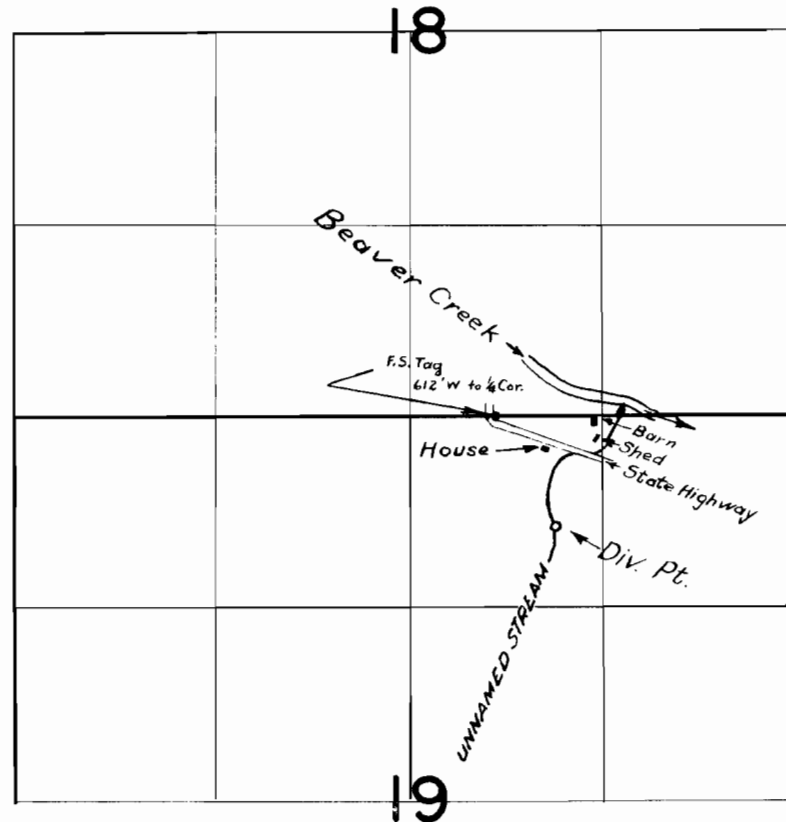

FINAL PROOF SURVEY
UNDER

Application No. 38976 Permit No. 29040
IN NAME OF

CLIFFORD P. & LAURABELLE LA FOND

Surveyed June 12 1964, by M. Bish.....

1964-1A

S. J. Jr.