


# Map of Columbia Fruit Growers Well

Scale 4" = 1 mile

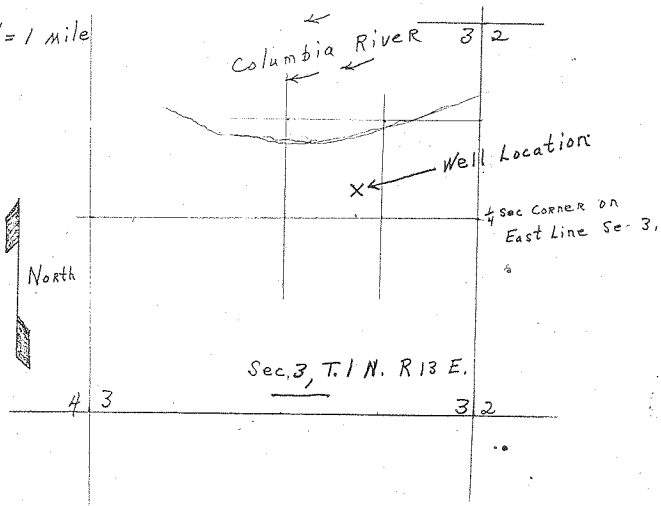

**RECEIVED**  
 JAN 12 1954  
 STATE ENGINEER  
 SALEM, OREGON