


# T. I. S. R. 2 W. W. M.

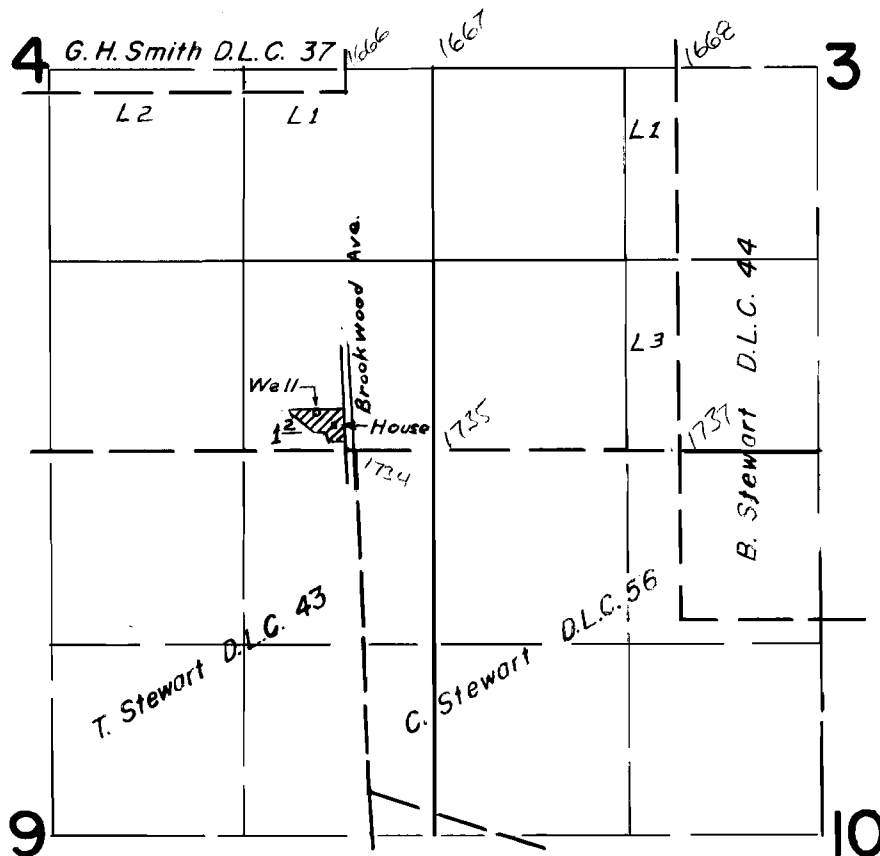

## FINAL PROOF SURVEY UNDER

Application No. G-1963 Permit No. G-1803  
IN NAME OF

*RUSSELL E. and PHYLLIS R. BROMS*

Surveyed May 14 1964, by M. Bish