


T.1N. R.2W. W.M.

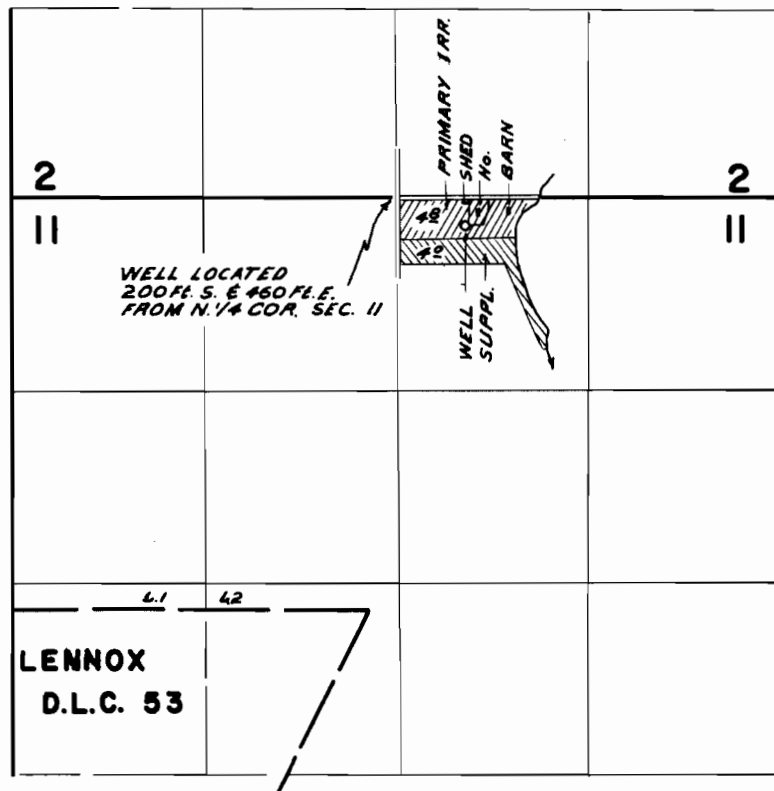

FINAL PROOF SURVEY
UNDER

Application No. G-2378 Permit No. G-2189
IN NAME OF

CARL J. BERG

Surveyed MAY 14 1965, by M. BISH