


T. 2N. R. 3W. W.M.

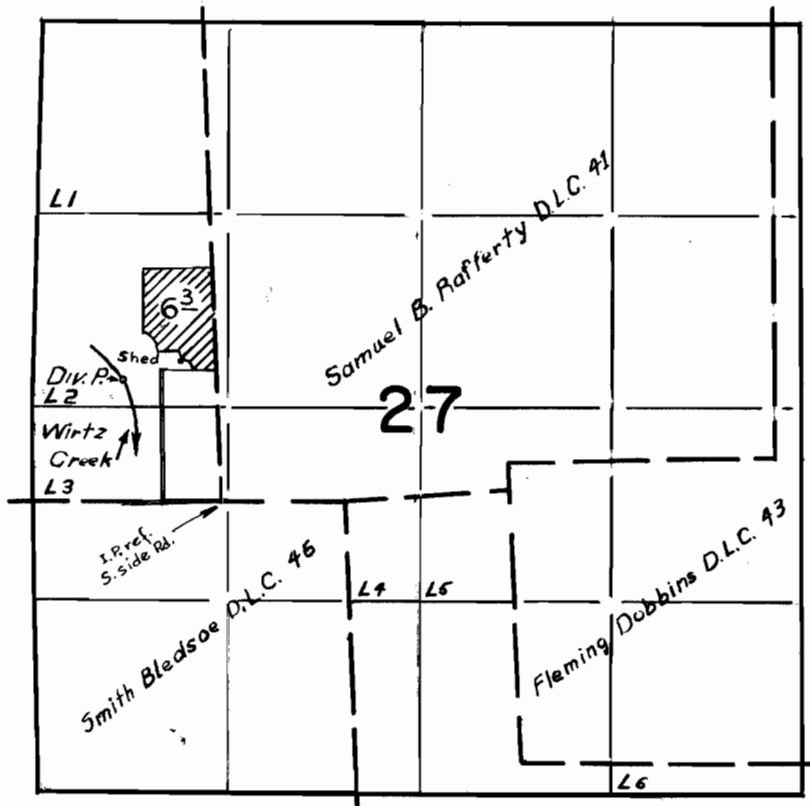

FINAL PROOF SURVEY
UNDER

Application No. 33854 Permit No. 26688
IN NAME OF

CLYDE F. BATEMAN

Surveyed APRIL 28, 1964, by M. BISH

1964-1A

S. L. J.