


T.2N. R.4W. W.M.

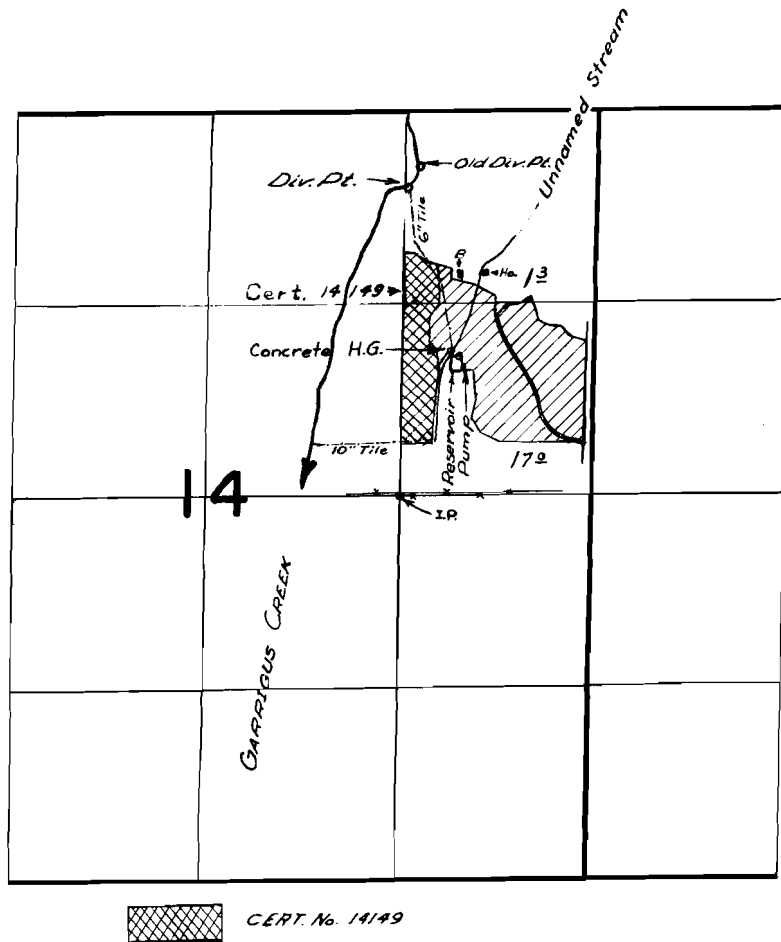

CERT. No. 14149

**FINAL PROOF SURVEY**  
UNDER

R-34083      R-2369  
Application No. 34084      Permit No. 26854  
IN NAME OF

WM. P. HERB

Surveyed APRIL 28, 1964, by M. BISH