


T.2N. R.4W. W.M.

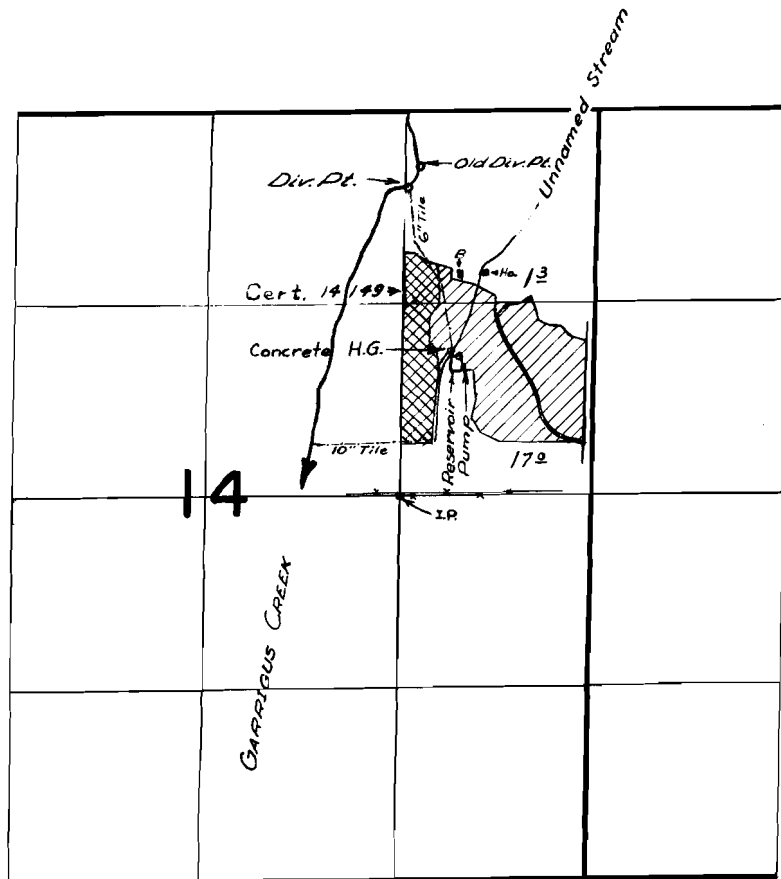

CERT. No. 14149

FINAL PROOF SURVEY
UNDER

R-34083 R-2369
Application No. 34084 Permit No. 26854
IN NAME OF

WM. P. HERB

Surveyed APRIL 28, 1964, by M. BISH