


T.2S. R.5W. W.M.

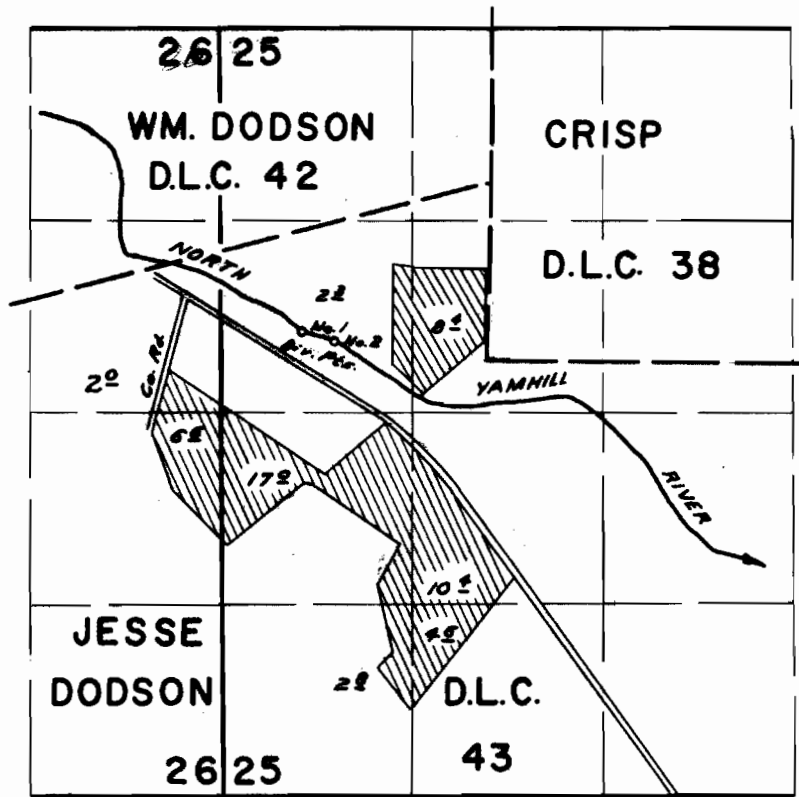

Div. Pl. No. 1 LOCATED 200 Ft. N. & 1275 Ft. W. FROM S.W. Cor. D.L.C. 38
Div. Pl. No. 2 LOCATED 150 Ft. N. & 1050 Ft. W.

FINAL PROOF SURVEY
UNDER

Application No. 34522 Permit No. 27113

IN NAME OF

HARLEY S. BELT

Surveyed AUG. 16, 1965, by L. COLEBANK