


T. 4 S. R. 4 W. W.M.

SECTION 5

J.C. HENDERSON D.L.C. 87

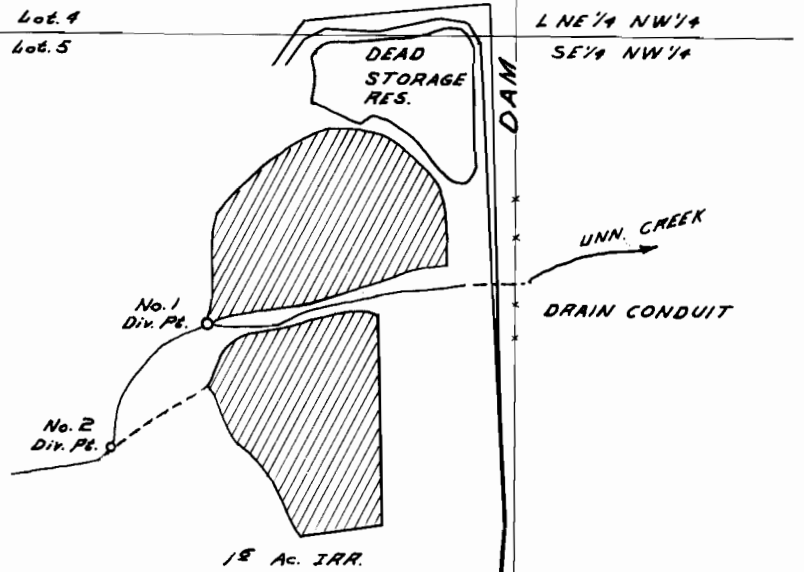

Div. Pt. No. 1 LOCATED 4360 Ft. N. & 225 Ft. E. FROM SE. Cor. D.L.C. 87
Div. Pt. No. 2 LOCATED 4230 Ft. N. & 125 Ft. E.

SCALE 1" = 200 Ft.

FINAL PROOF SURVEY
UNDER

Application No. 37191 Permit No. 27719
IN NAME OF

FRANK DONNELLY

Surveyed APR. 26 1965, by M. BISH