T. 11 S. R. 5 W.W.M.

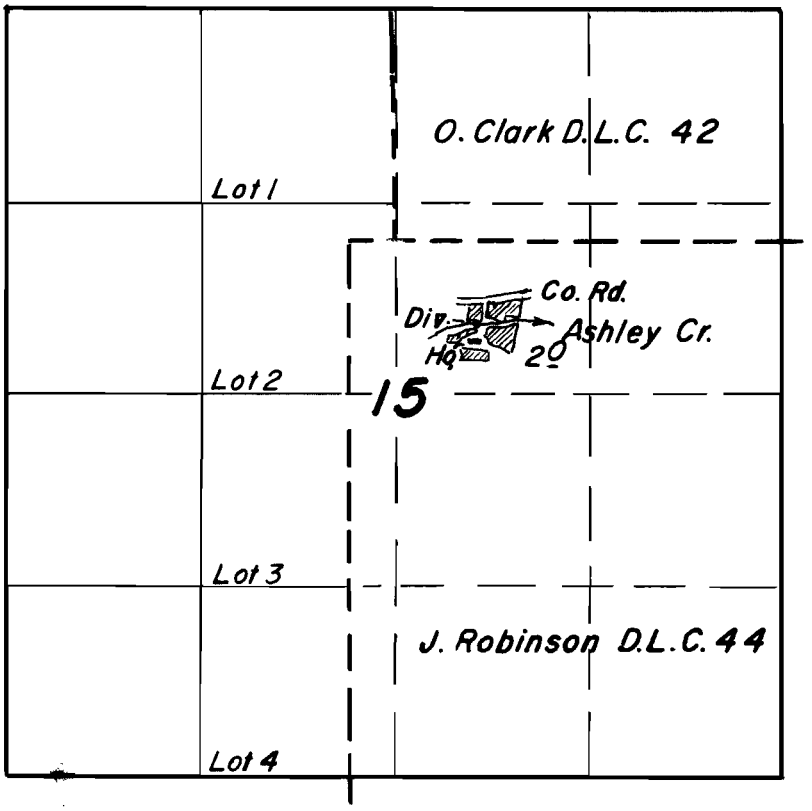

FINAL PROOF SURVEY
UNDER

Application No. 38939 Permit No. 28974
IN NAME OF

Harold Nelson

Surveyed July 20 1964, by Floyd L. Siegmund

2-1964-A