


T. 7 S. R. 1 W. W. M.

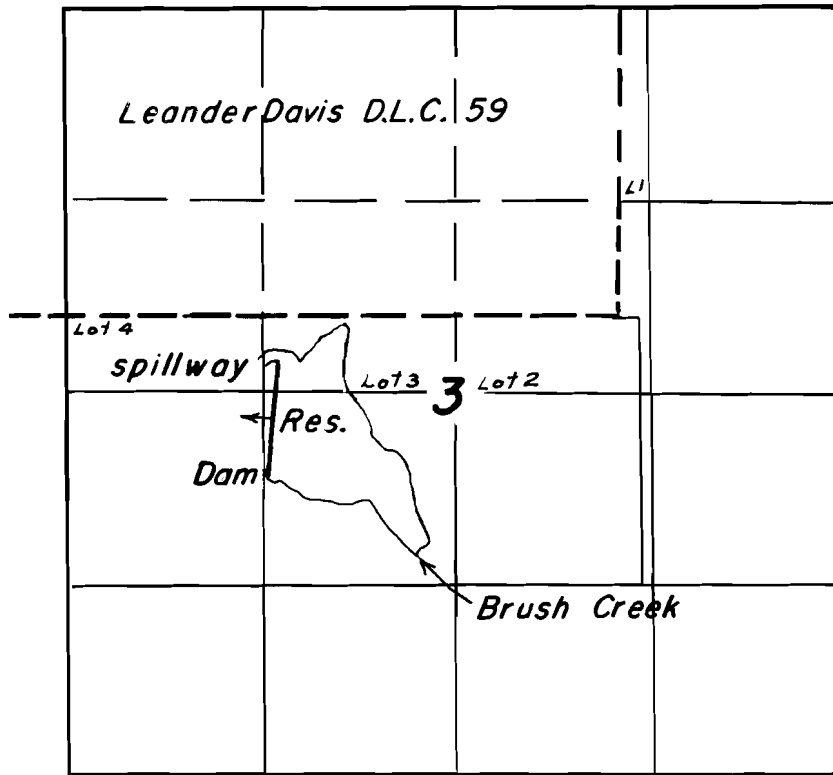

FINAL PROOF SURVEY
UNDER

Application No. *38014* Permit No. *28698*
R-38013 *R-3247*
IN NAME OF

Virgil E. Pettit

Surveyed *June 11* 1964, by *Floyd L. Siegmund*