


T. 10 S. R. 5 E. W. M.

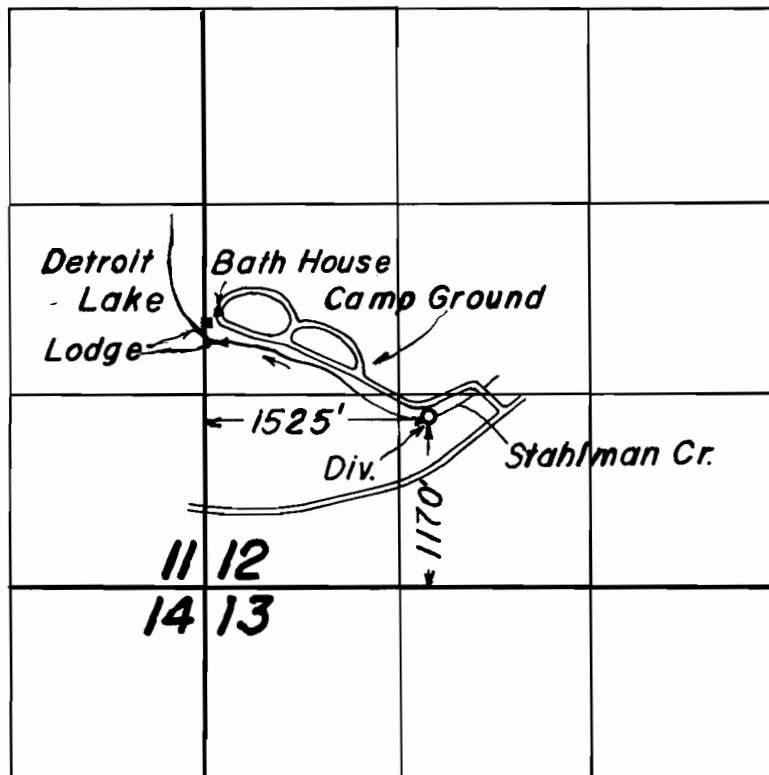

FINAL PROOF SURVEY
UNDER

Application No. 38410 Permit No. 28609
IN NAME OF

North Santiam Sportsmen's Club

Surveyed June 1, 1965 by F. Siegmund.