


T.6S.R.10W.W.M.

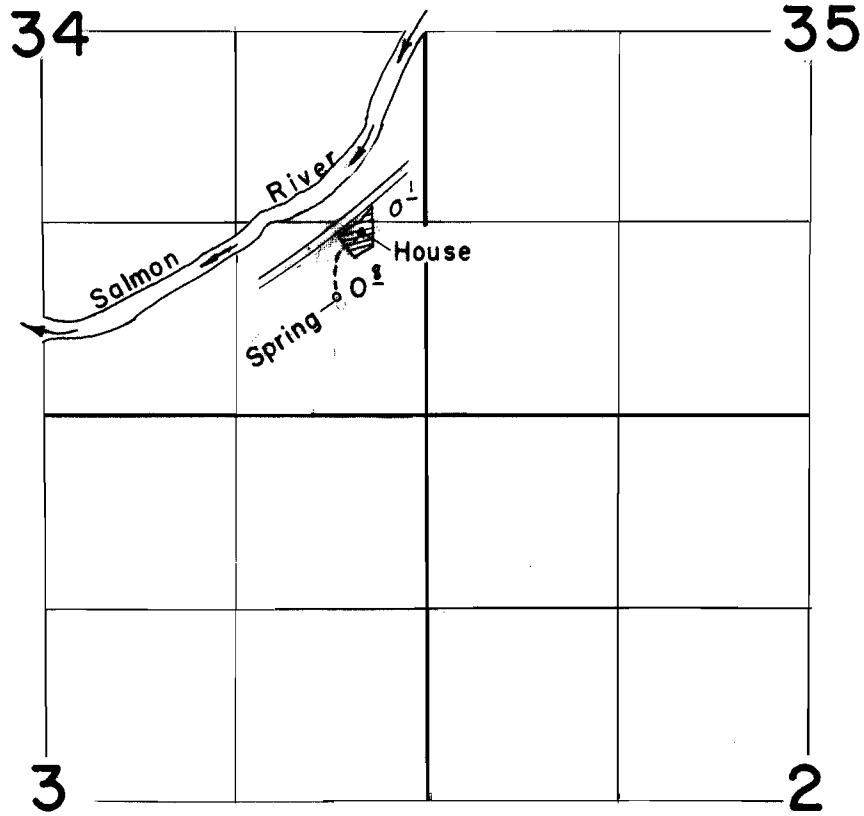

**FINAL PROOF SURVEY**  
UNDER

Application No. 33170..... Permit No. 26486...  
IN NAME OF

..... Charles A. & Nora Ritz .....

Surveyed Sept. 20, 1964, by F. Siegmund.....