


T.5S.R.3W.W.M.

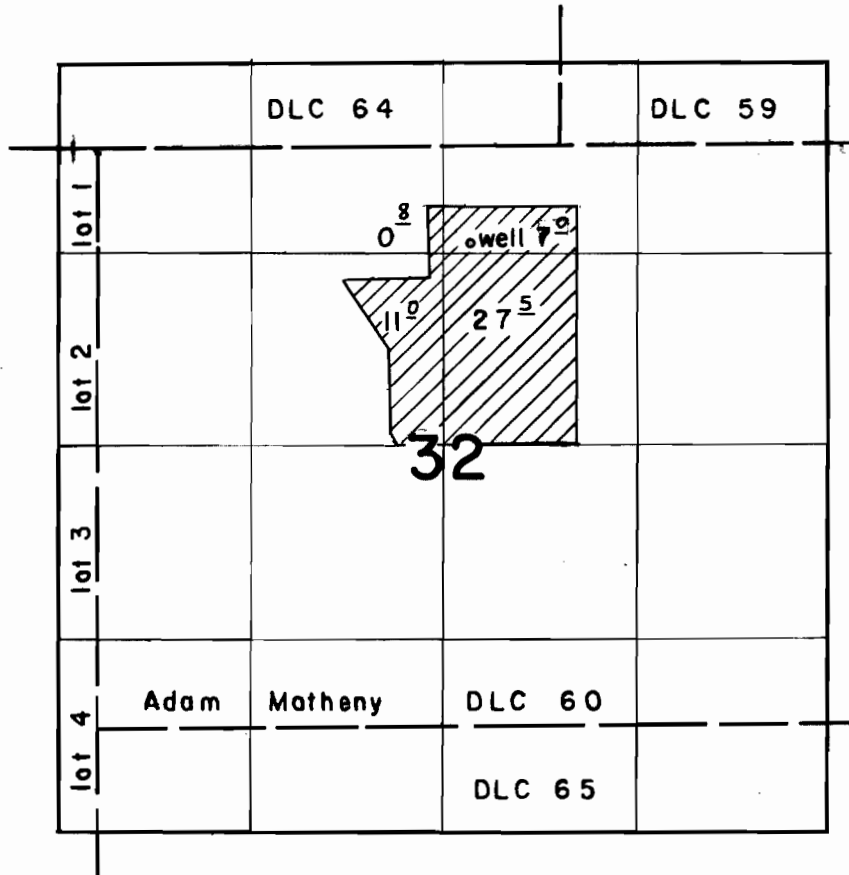

FINAL PROOF SURVEY UNDER

Application No. G-2428. Permit No. G-2238.
IN NAME OF

Clements Schrock

Surveyed Aug. 5, 1964, by R. Jackson