


T.II S.R.5 W.W.M.

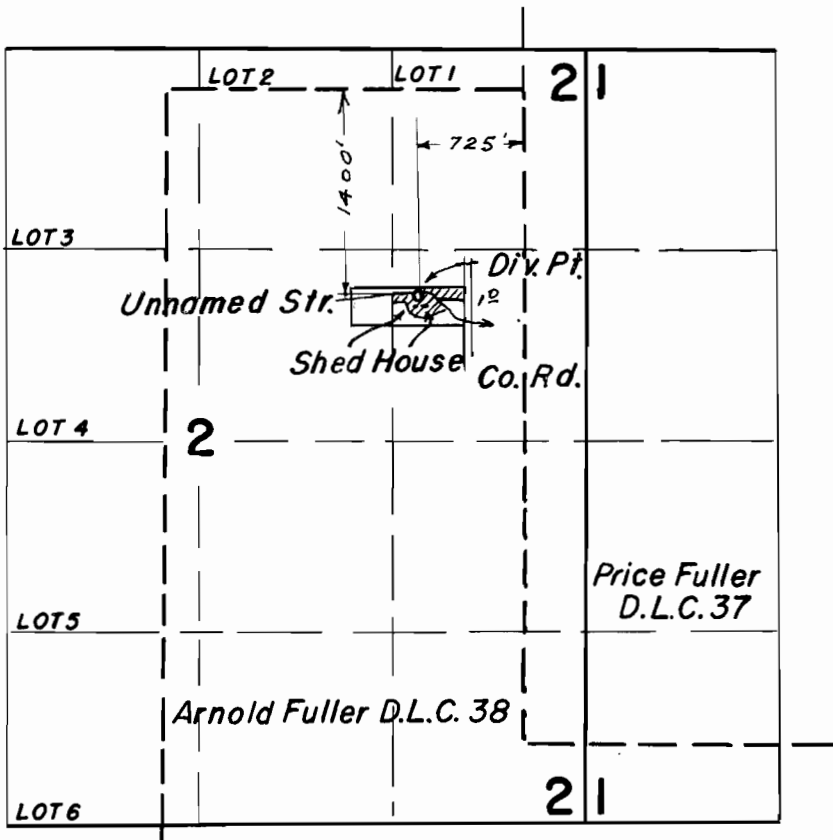

FINAL PROOF SURVEY

UNDER

Application No. 37764 Permit No. 28/38
IN NAME OF

Lawrence N. Larson

Surveyed July 23 1965, by F. Siegmund