


T.14 S. R. 39 E. W.M.

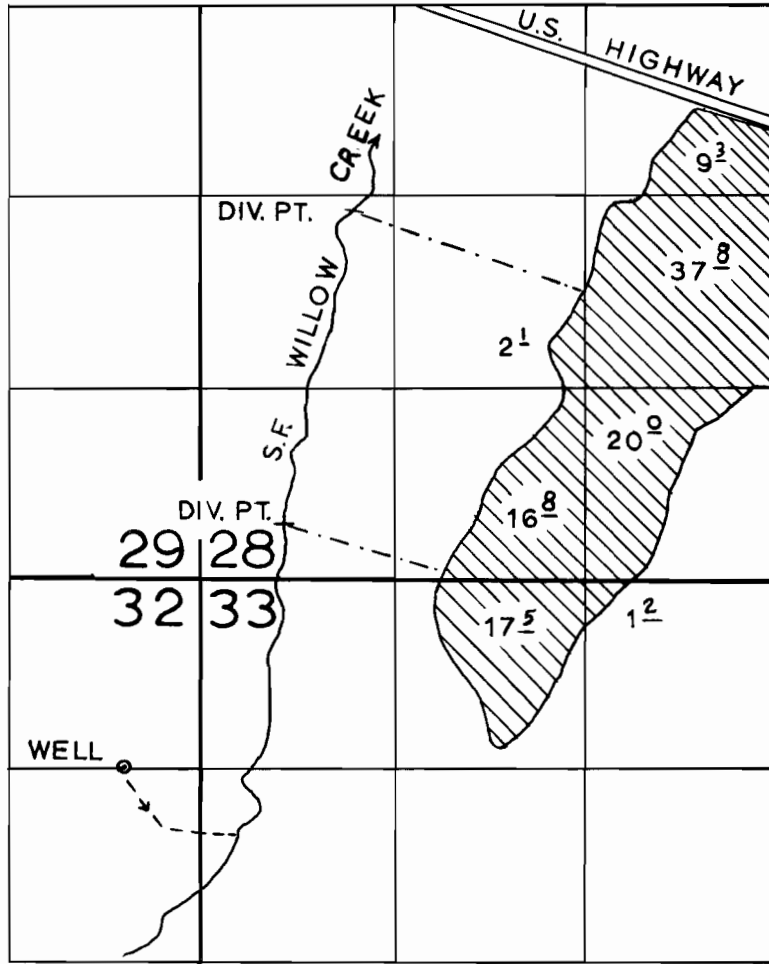

FINAL PROOF SURVEY
UNDER

Application No. G-2357. Permit No. G-2175.
IN NAME OF

RAY DUNCAN

Surveyed NOV. 5, 1964., by *E.W. Elfring*