


Basin 6

P-28170
33313

T.133. R.29E. W.M.

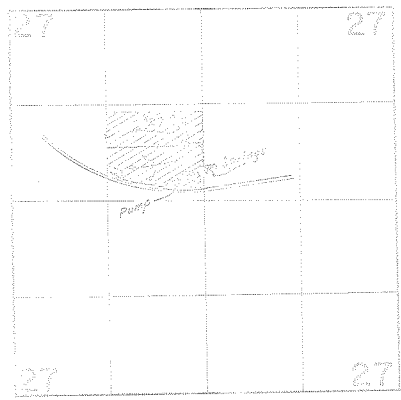

FINAL PROOF SURVEY
UNDER

Application No. 37568, Permit No. 28170....
IN NAME OF

JAMES L. WORTH

Surveyed Oct. 26, 1964, by S. Jackson.....