


T.9 S.R.9 W. W.M.

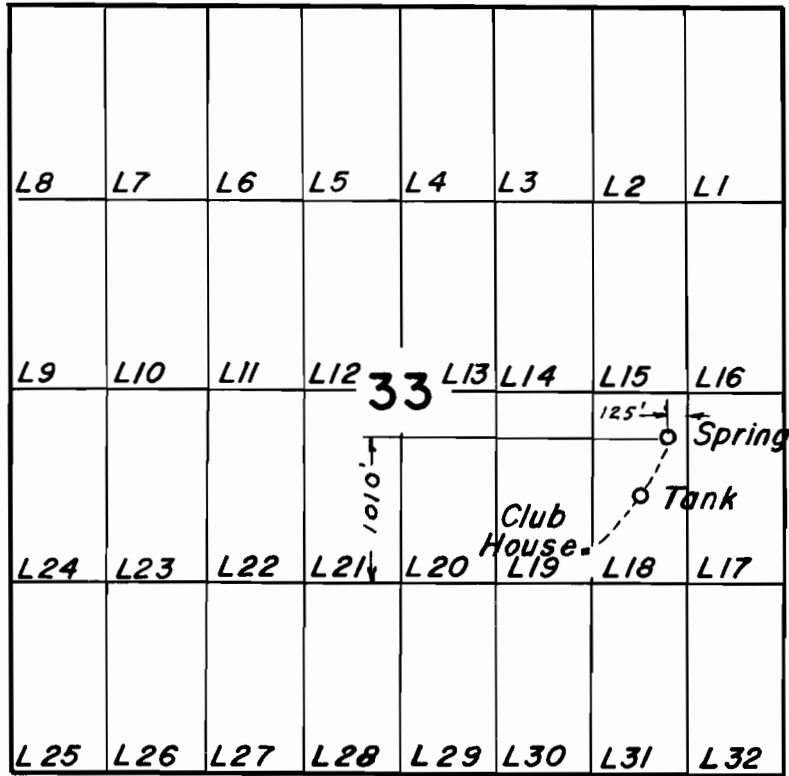

FINAL PROOF SURVEY UNDER

Application No. 37784 Permit No. 28146
IN NAME OF

Logsdan Community Club Inc.

Surveyed Oct. 15 1965, by F. Siegmund