


T.9 S. R. 3 E. W. M.

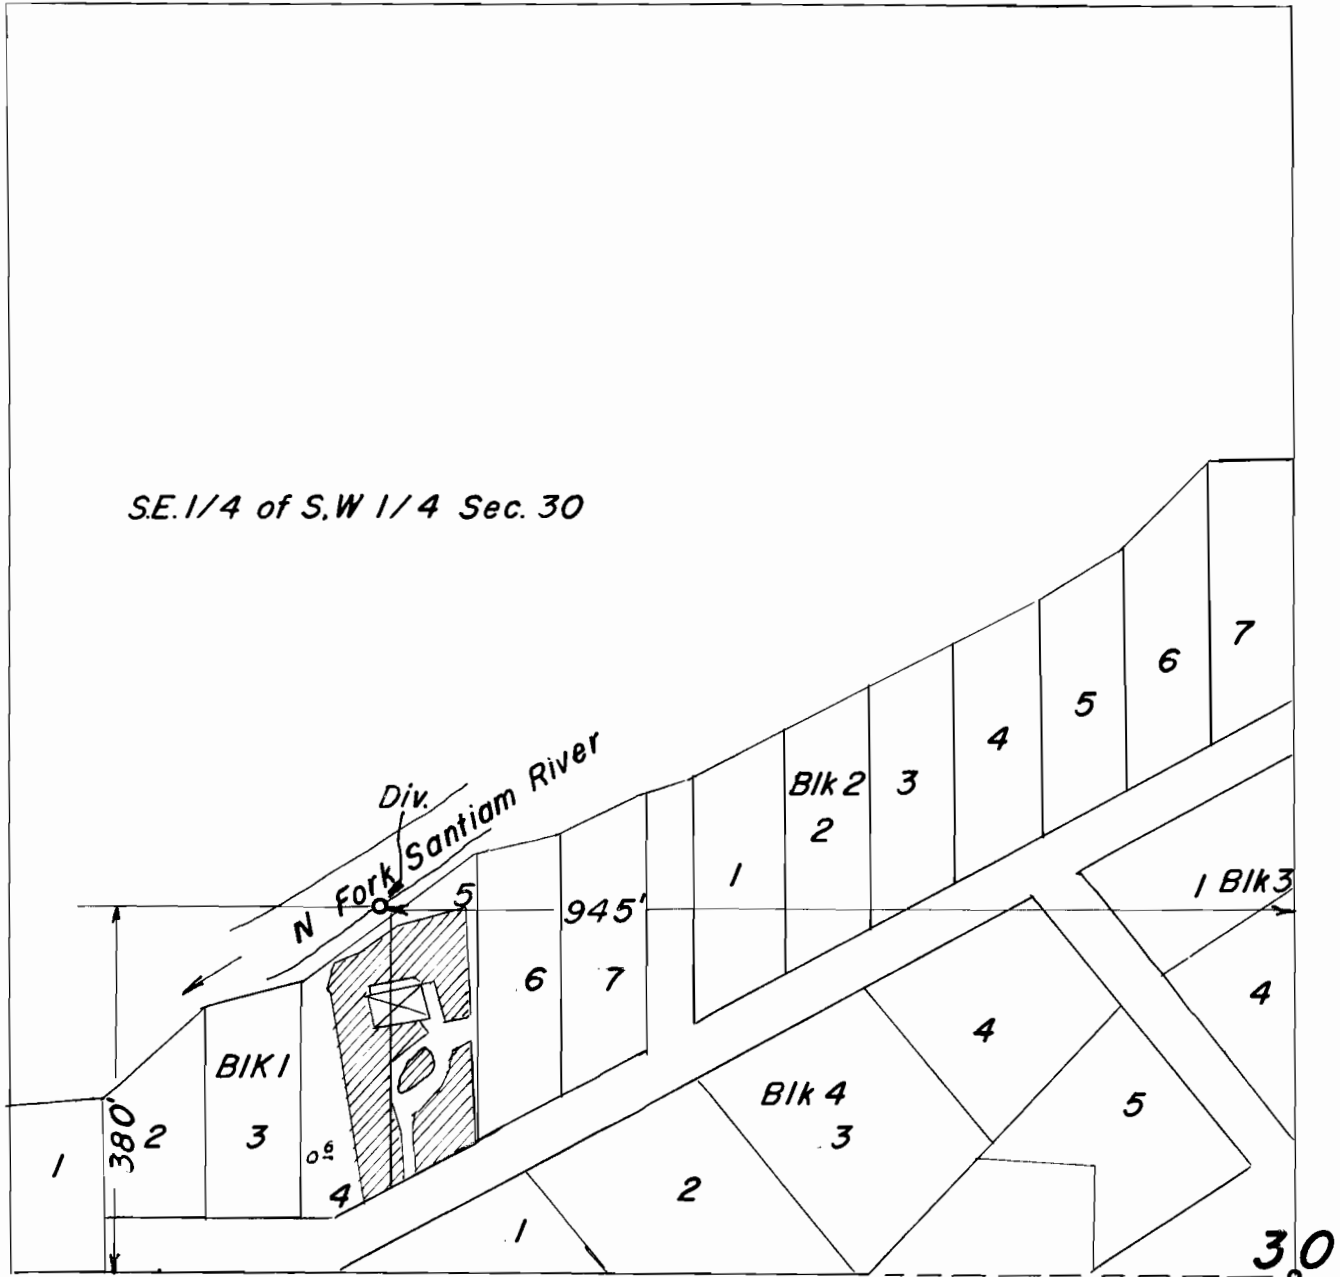

SE. 1/4 of S.W. 1/4 Sec. 30

Scale 200' = 1"

FINAL PROOF SURVEY
UNDER

Quarter Corner

Application No. 39747 Permit No. 29563
IN NAME OF

Burton Boroughs

Surveyed May 21 1965, by F. Siegmund