


T. 7 S. R. 1 W. W. M.

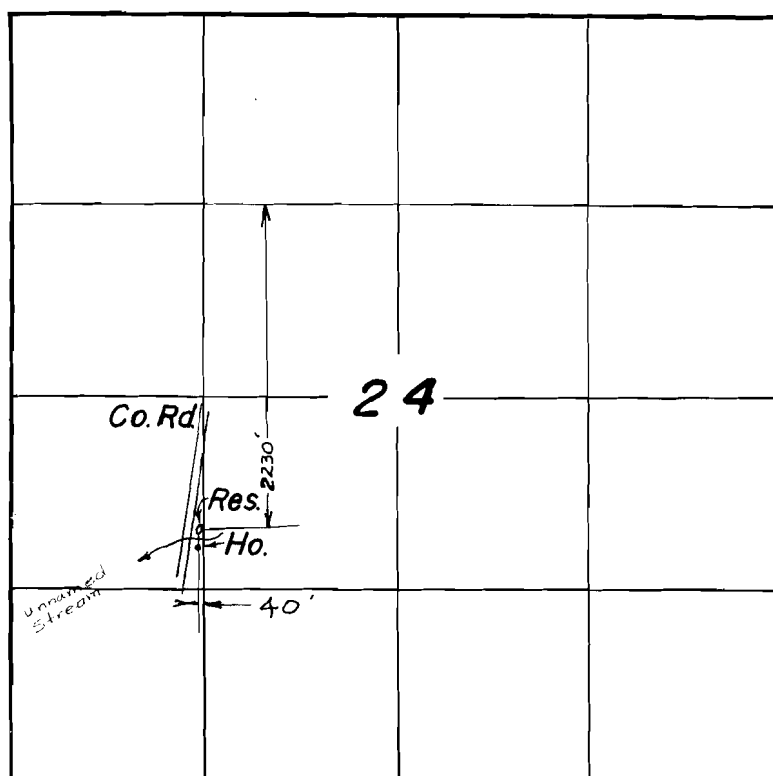

FINAL PROOF SURVEY
UNDER

Application No. *R-37386* Permit No. *R-2960*
IN NAME OF

Paul Henry

Surveyed *Sept. 19* 1965, by *F. Siegmund*